

Name **John Anderson**

Service No. **197**

Address **30 Outlook Drive**

**Lexington**

Location

Kind of Pipe

Size **6"**

Size of Main **8"**

~~REPAIR~~ **New Service**

COM. 9-14-53

Location

Date	Material	Amount	Total	Date	Amount
7/53	Labor	50 50		7-20-53	150 00
	10% overhead	5 05	55 55	9-14-53	(32 89)
	50' 6" Sewer Pipe @.3036		15 18		117 11
	1-6" Elbow		1 88		
	Joint Compound		3 00		
	6 Hr. Town Shovel @5.00		30 00		
	2 Hr. Trucking		1 50		
	Patching 10 x 3		10 00		
			117 11		
	<b>Labor</b>				

**TOWN OF LEXINGTON—DEPT. OF PUBLIC WORKS**  
**SEWER DIVISION**

DATE .....

NO. ....


The undersigned applies for the construction of a particular sewer connecting No. ....  
 Street and hereby agrees to comply with the Rules and Regulations governing the construction **and use of Particular**  
 Sewers, as now or at any future time established by the Board of Selectmen.

Am't of estimate \$.....

Am't Paid \$.....

..... Owner

Sketch of Service Here **30**

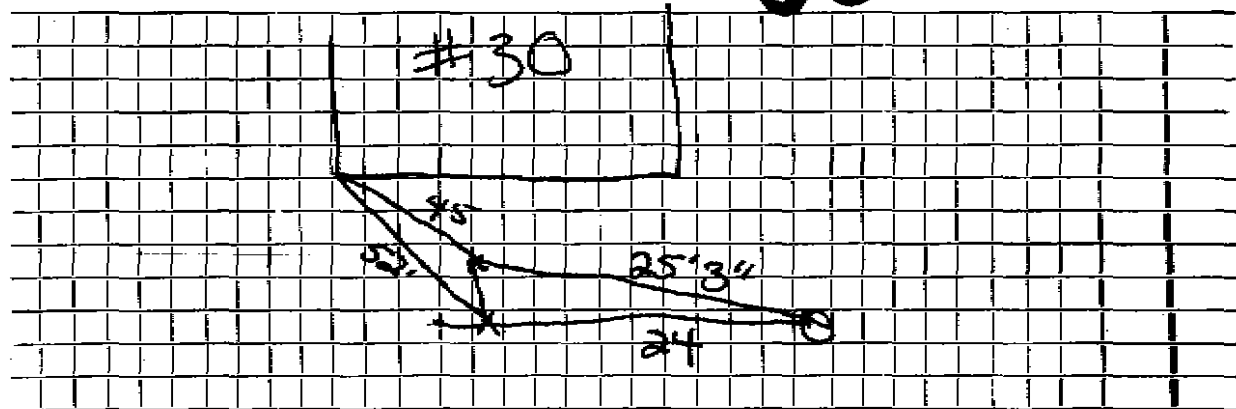

Connection made in ..... Street.

Work completed ..... 19..

Remarks:

*Repair made Oct 16, 1995*

*5' 6" → VC  
 2 6" x 6" Clay to PVC*