

Name **John Manning**

Service No. **102**

Address **40 Outlook Drive**

Lexington

Location

Kind of Pipe **COM. 9-22-52**

Size **6"**

Size of Main **8"**

~~Repair~~ **New Service**

Location

Date	Material	Amount	Total	Date	Amount
8/5/52	Labor	59 47		7-11-52	Deposited 175 00
8/6/52	Labor	26 76		9-22-52	Refunded 7 61
	10% Overhead	8 62	94 85		167 39
	80' - 6" Sewer Pipe @ .342		27 36		
	1 - 6" elbow @1.88		1 88		
	joint compound		4 80		
	5 hr. Town shovel @5.00		25 00		
	2 hr. trucking		1 50		
	patching 12 x 3		12 00		
			167 39		
	Labor				

**TOWN OF LEXINGTON—DEPT. OF PUBLIC WORKS
SEWER DIVISION**

DATE.....

NO.


The undersigned applies for the construction of a particular sewer connecting No.....
Street and hereby agrees to comply with the Rules and Regulations governing the construction and use of Particular
Sewers, as now or at any future time established by the Board of Selectmen.

Am't of estimate \$.....

Am't Paid \$.....

..... Owner

Sketch of Service Here

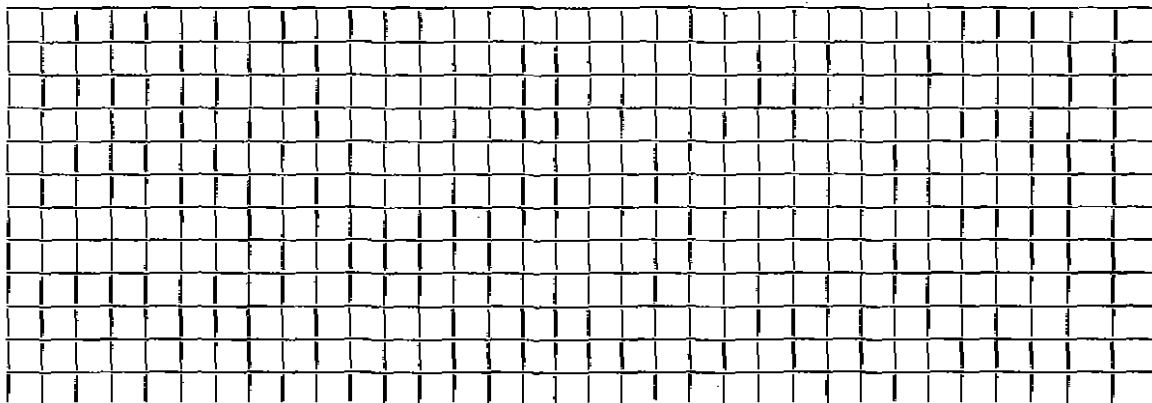

Connection made in..... Street.

Work completed.....19..

Remarks: