

Name Robert W. Hunter

Service No. 755

Address 45 Outlook Drive

45 Outlook Drive

Location

Kind of Pipe

Size 6"

Size of Main 8"

~~Repair~~ ~~Renewal~~ ~~New Service~~

COM. 10-10-55

Location

Date	Material	Amount	Total	Date	Amount
8-9-55	Labor	35 60		7-25-55	Deposited 125 00
	10% overhead	3 56	39 16	10-10-55	Refunded (25 34)
	50' -6" sewer pipe @ .32		16 00		99 66
	joint compound		3 00	8-22-03	Repair, From Property
	10 x 3 patching		10 00		To Main JMR
	2 hrs. trucking @ .75		1 50		(Gas Co.)
	4 hrs. Littlefield shovel @ 7.50		30 00		
			99 66		
8-22-03	9'6" PVC				
	2-6x6 Clay to PVC Fern.				
	Labor				

TOWN OF LEXINGTON—DEPT. OF PUBLIC WORKS
SEWER DIVISION

DATE

NO.


The undersigned applies for the construction of a particular sewer connecting No.
Street and hereby agrees to comply with the Rules and Regulations governing the construction and use of Particular
Sewers, as now or at any future time established by the Board of Selectmen.

Am't of estimate \$.....

Am't Paid \$.....

..... Owner

Sketch of Service Here

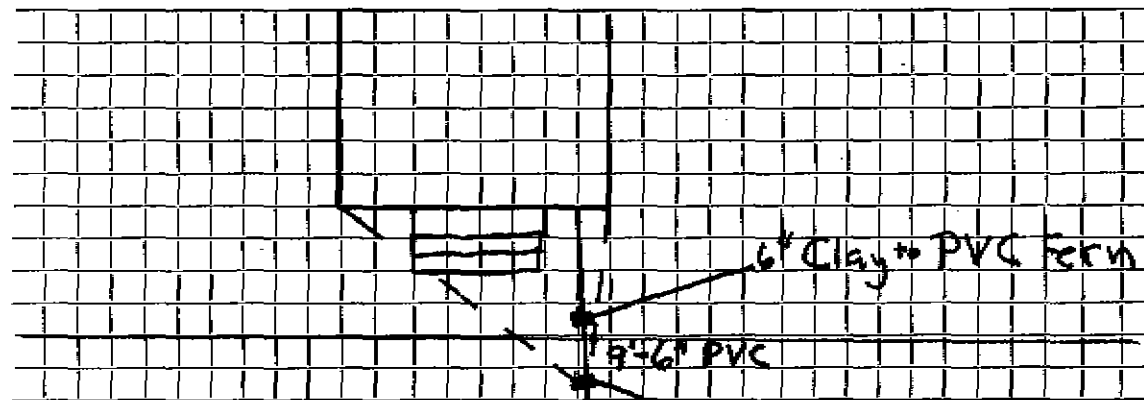

Connection made in Street. *6\"/>*

Remarks:

19..