

Name ~~Edwards~~ Simpson

Service No. 170

Address 16 Outlook Drive

46 Outlook Drive

Kind of Pipe

Size 6"

Size of Main 8"

~~Excavation~~ New Service

Location *Corner 1121 W*


Date	Material	Amount	Total	Date	Amount
10-60	LABOR	87.85		12-64	3.50 00
11-60	"	72.67		11-21-41	63.86
13-60	"	28.80			337.14
14-60	"	28.80	217.92		
	10% O.H.		21.79		
66	6" Transite pipe @ .78		51.48		
1	6" 22# Transite Bend		6.21		
1	11# Transite Elbow		2.24		
3	hrs. Town Shovel @ 6.50		19.50		
5	hrs. Trucking @ 3.00		15.00		
1	hr. Trencher @ 3.00		3.00		
			337.14		

DATE _____

TOWN OF LEXINGTON — BOARD OF PUBLIC WORKS

SEWER DIVISION

Sketch of Service Here

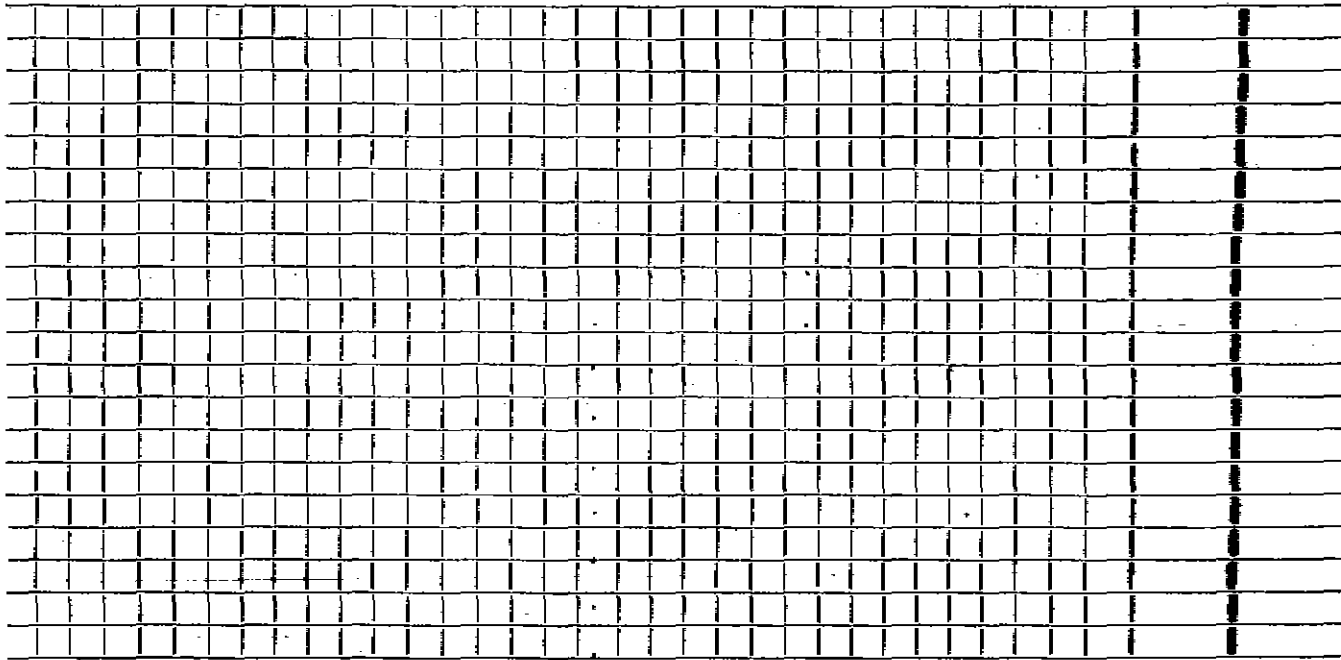

Connection made in Street. Work completed

Remarks:

.....

.....