

Name Earle B. Sukeforth

Service No. 103

Address 48 Outlook Drive

48 Outlook Drive

Location

Kind of Pipe

Size 6"

Size of Main 8"

~~Repair~~ ~~Renewal~~ New Service


Location Comm 12-4-61

Date	Material	Amount	Total	Date	Amount
9/61	Labor	84 83		8-7-61	300 00
10/61	"	19 46		12-4-61	74 68
		104 29			225 32
	10% O.H.	10 43	114 72		
	83' 6" Transite Pipe @ .78		64 74		
	1 90° Transite Elbow		5 40		
	1 11 1/4° Transite Bend		5 10		
	1 22 1/2° Transite Elbow		2 24		
	1 6" Adapter		1 62		
	3 Hrs. Town Shovel @ 6.50		19 50		
	1 Hr. Trojan Loader @ 3.00		3 00		
	3 Hrs. Trucking @ 3.00		9 00		
			225 32		

DATE _____

TOWN OF LEXINGTON — BOARD OF PUBLIC WORKS
SEWER DIVISION

Sketch of Service Here

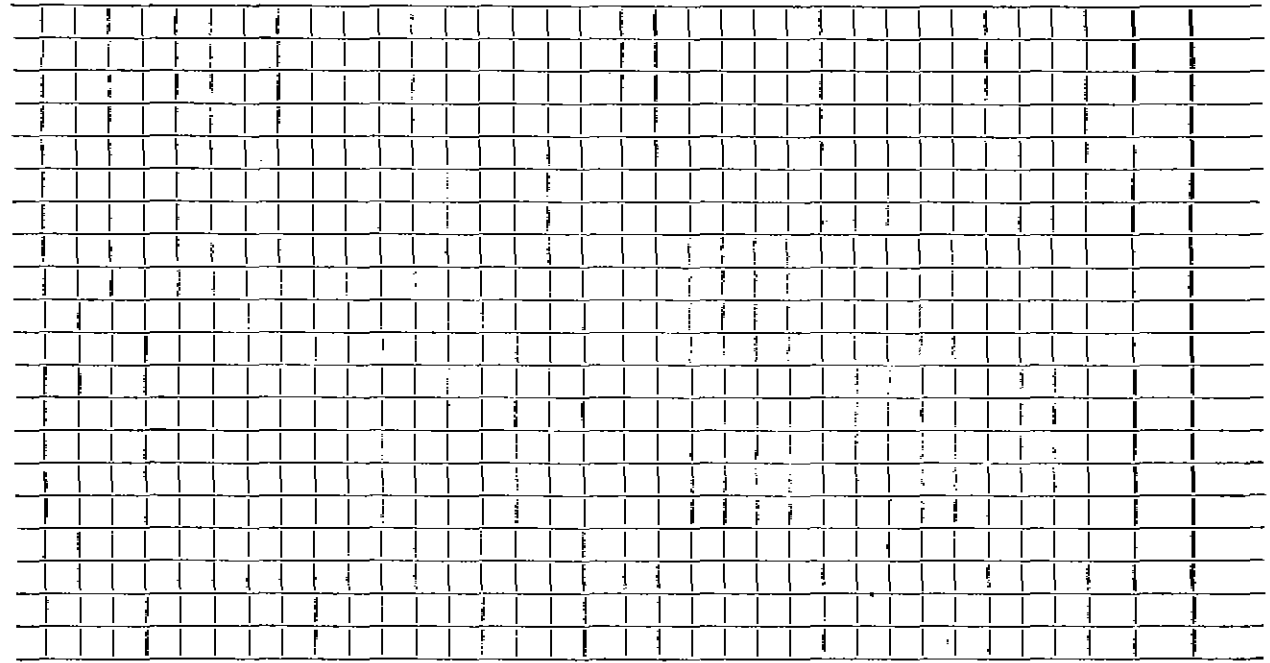

Connection made in Street. Work completed

Remarks:
.....
.....