

Name Otis J. Connor

Service No. 170

Address 54 Outlook Drive

54 Outlook Drive
Lexington, Mass.

Location

Kind of Pipe

Size 6"

Size of Main 8"

~~Repl. Old~~ New Service

com. 12-31-51

Location

Date	Material	Amount	Total	Date	Amount
1/5/51	Labor	62 56		11-25-51	Deposited 125 -
	10% overhead	6 26	68 82	12-31-51	Re-fund 116 19
	46' - 6" sewer pipe @ .342		15 73		128 81
	joint compound		2 76		
	4 hrs. Town shovel @ 5.00		20 00		
	2 hrs. trucking		1 50		
			108 81		
	Labor				

TOWN OF LEXINGTON—DEPT. OF PUBLIC WORKS

SEWER DIVISION

DATE

NO.


The undersigned applies for the construction of a particular sewer connecting No.
Street and hereby agrees to comply with the Rules and Regulations governing the construction and use of Particular
Sewers, as now or at any future time established by the Board of Selectmen.

Am't of estimate \$.....

Am't Paid \$.....

..... Owner

Sketch of Service Here

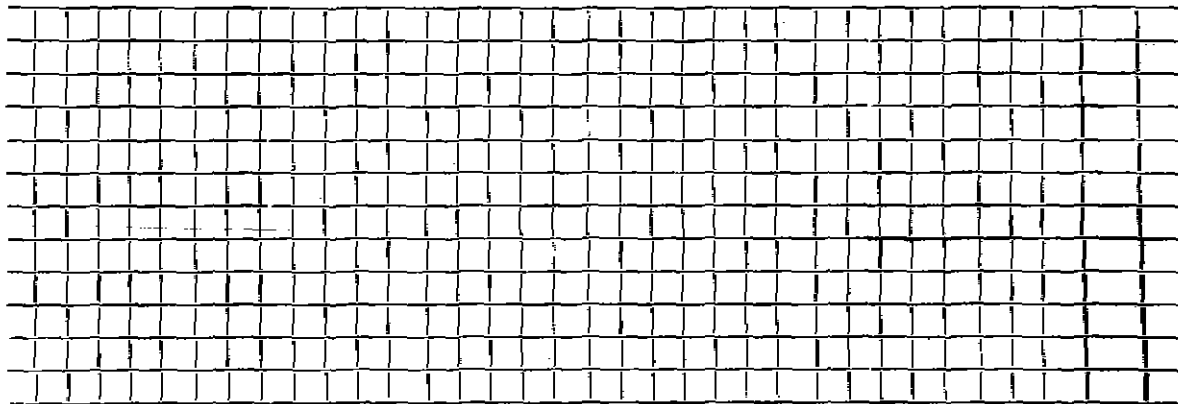

Connection made in Street.

Work completed 19..

Remarks: