

Name **Arnold J. Knox**Service No. **149**Address **66 Outlook Drive****Lexington, Mass.**

Location

Kind of Pipe

Size **6"**Size of Main **8"**~~Repair~~ **New Service***CON-11-13-51*

Location

Date	Material	Amount	Total	Date	Amount
10/15/51	Labor	60 15	60 15	10-4-51	Deposited 150 00
	10% overhead		6 02	11-13-51	Refunded 97 73
	50' 6" sewer pipe @ .342		17 10		
	joint compound		3 00		
	5 hrs. Town shovel @ 5.00		25 00		
	2 hrs. trucking @ 3.00		6 00		
			<u>117 27</u>		
	Labor				

TOWN OF LEXINGTON—DEPT. OF PUBLIC WORKS

SEWER DIVISION

DATE

NO.


The undersigned applies for the construction of a particular sewer connecting No.
Street and hereby agrees to comply with the Rules and Regulations governing the construction and use of Particular
Sewers, as now or at any future time established by the Board of Selectmen.

Am't of estimate \$.....

Am't Paid \$.....

..... Owner

Sketch of Service Here

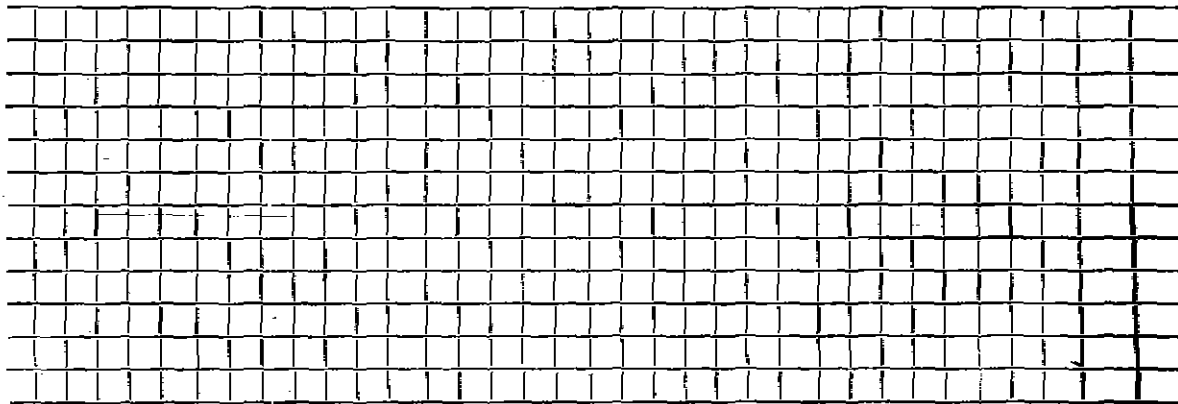

Connection made in Street.

Work completed 19..

Remarks:

Handwritten signature or initials in the remarks section.