

Name John Nygard

Service No. 171

Address 59 Outlook Drive

59 Outlook Drive

Location

Kind of Pipe

Size 6"

Size of Main 8"

Remarks: ~~General~~ - New Service

COM. 12-31-54

Location

Date	Material	Amount	Total	Date	Amount
2/29/54	Labor		53 93	12-22-54	Deposited 175 00
	10% overhead		5 39	12-31-54	Refunded (3 64)
	108' - 6" Sewer pipe @ .52		34 56		171 36
	Joint compound		6 48		
	7 2/3 hrs. Littlefield Shovel @ 7.50		57 50		
	2 hrs. trucking @ .75		1 50		
	Patching 12x3		12 00		
			171 36		
	Labor				

TOWN OF LEXINGTON—DEPT. OF PUBLIC WORKS

SEWER DIVISION

DATE

NO.


The undersigned applies for the construction of a particular sewer connecting No.
Street and hereby agrees to comply with the Rules and Regulations governing the construction and use of Particular
Sewers, as now or at any future time established by the Board of Selectmen.

Am't of estimate \$.....

Am't Paid \$.....

..... Owner

Sketch of Service Here

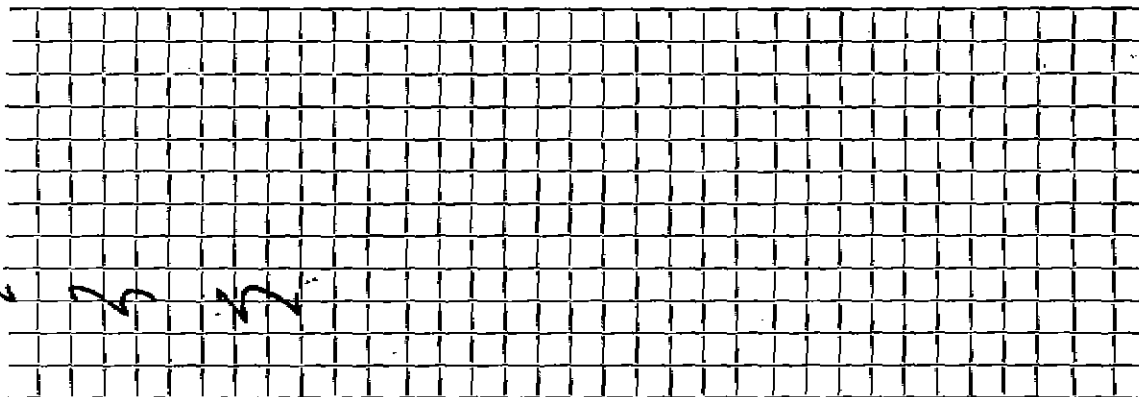

Connection made in Street: Work completed 19..

Remarks: