

Name **Walter Powers**Service No. **145**Address **68 Outlook Drive****Lexington, Mass.**

Location

Kind of Pipe

Size **6"**Size of Main **8"**~~Repair~~ **New Service***24-11-13-51*

Location

Date	Material	Amount	Total	Date	Amount
10/11/51	Labor	49 64	49 64	10-13-51	Deposited 150 -
	10% overhead		4 96	11-13-51	Refunded 56 03
	46' - 6" sewer pipe @ .342		15 73		93 97
	1 - 6" elbow		1 88		
	joint compound		2 76		
	2 hrs. Town shovel @ \$5.00		10 00		
	1 hr. Hough Loader		3 00		
	2 hrs. trucking @ 3.00		6 00		
			93 97		
	Labor				

TOWN OF LEXINGTON—DEPT. OF PUBLIC WORKS

SEWER DIVISION

DATE

NO.


The undersigned applies for the construction of a particular sewer connecting No.
Street and hereby agrees to comply with the Rules and Regulations governing the construction and use of Particular
Sewers, as now or at any future time established by the Board of Selectmen.

Am't of estimate \$.....

Am't Paid \$.....

..... Owner

Sketch of Service Here

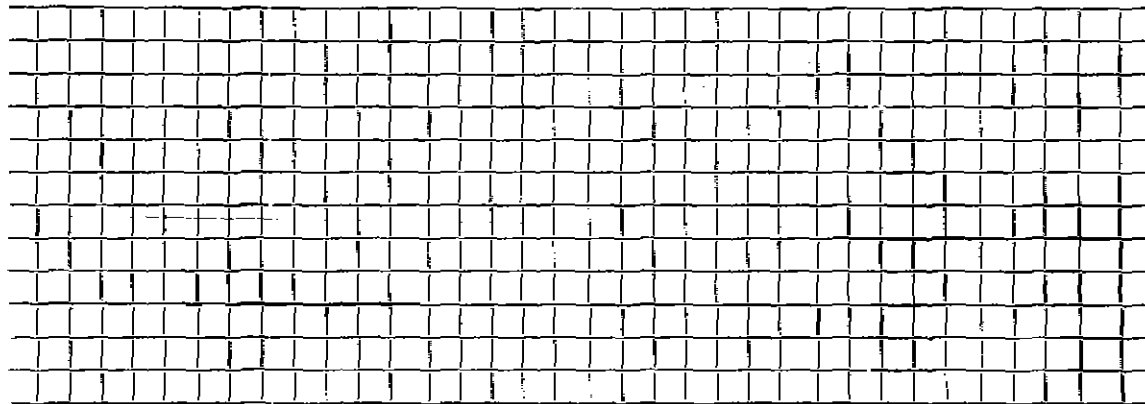

Connection made in Street.

Work completed 19..

Remarks: