

DATE _____

TOWN OF LEXINGTON — BOARD OF PUBLIC WORKS


SEWER DIVISION

Sketch of Service Here

72

Lot 144

PT
145

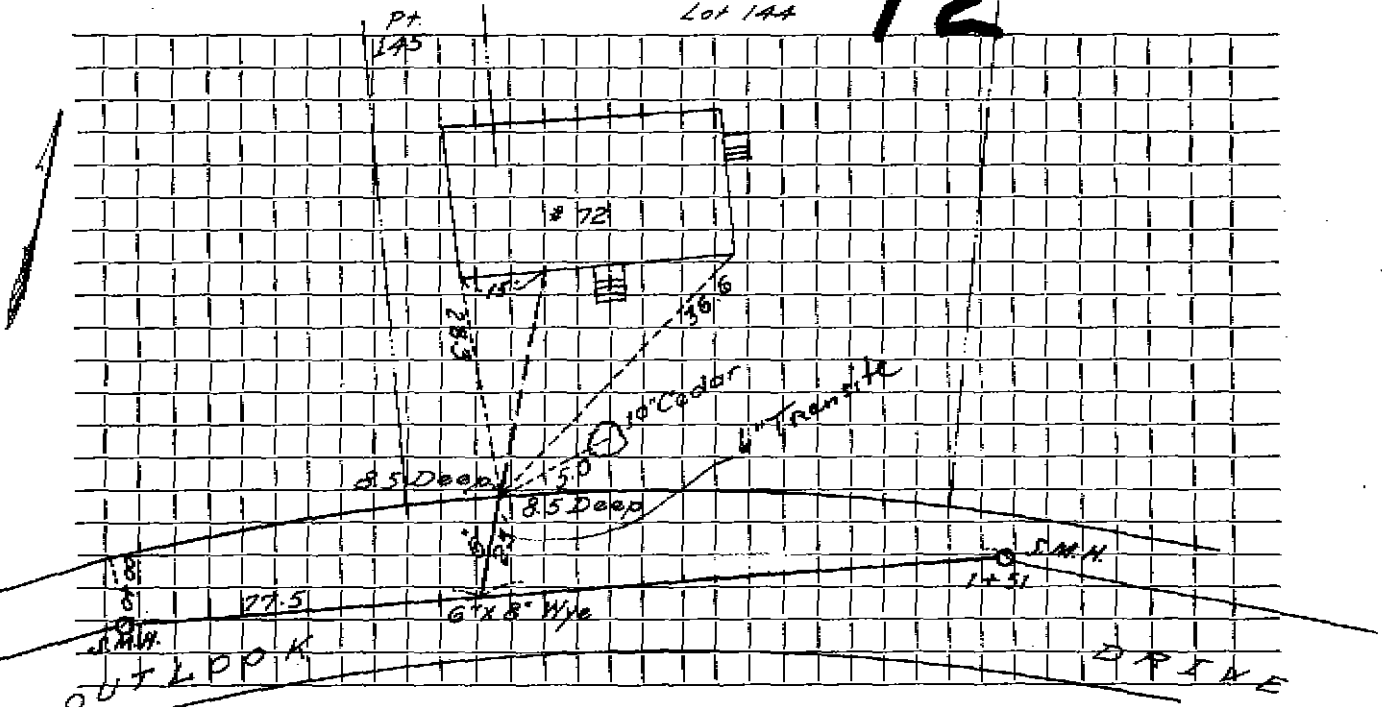

Connection made in Street. Work completed

Remarks: