


DATE _____

TOWN OF LEXINGTON — BOARD OF PUBLIC WORKS

SEWER DIVISION

Sketch of Service Here

78 Outlook DR

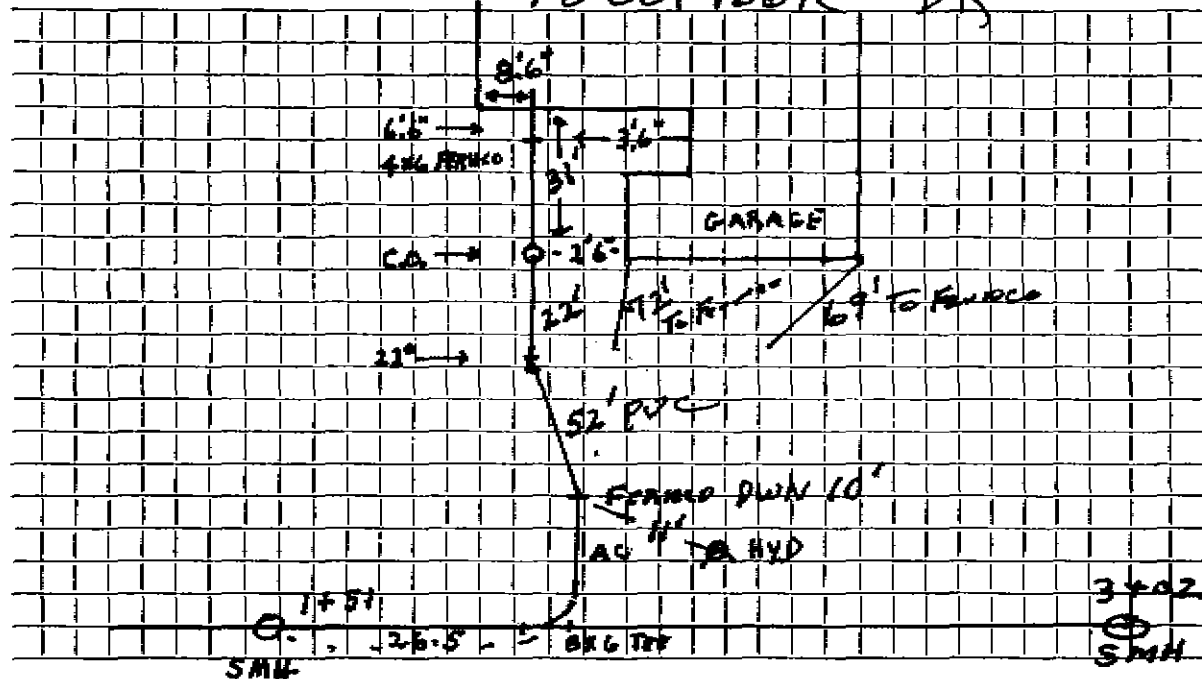

Connection made in Street. Work completed

Remarks: TIE TO EXISTING AC ~~LINE~~ off GARAGE