

Name Irwin A. Pless

Service No. 8

Address 88 Outlook Drive

88 Outlook Drive

Location Lot I.C. 55 & Pt. 141

Kind of Pipe

Size 6"

Size of Main 8"


Repair—Renewal—New Service Lucente #1997

Location JUN 5 1972

| Date | Material | Amount | Total | Date | Amount |
|---------|-----------------------------------|--------|--------|-----------------|----------------|
| | 20' 6" Transite pipe @ | 7.50 | 150.00 | 1-11-72 | Deposit 150.00 |
| 1/13/72 | 142' 6" Transite pipe | | | | |
| | 20' 4" Cast Iron | | | | |
| | | | | 20' 6" Transite | |
| | | | | 1 6" X 8" Wye | |
| | | | | | |
| | | | | | |
DATE _____

TOWN OF LEXINGTON — BOARD OF PUBLIC WORKS
SEWER DIVISION

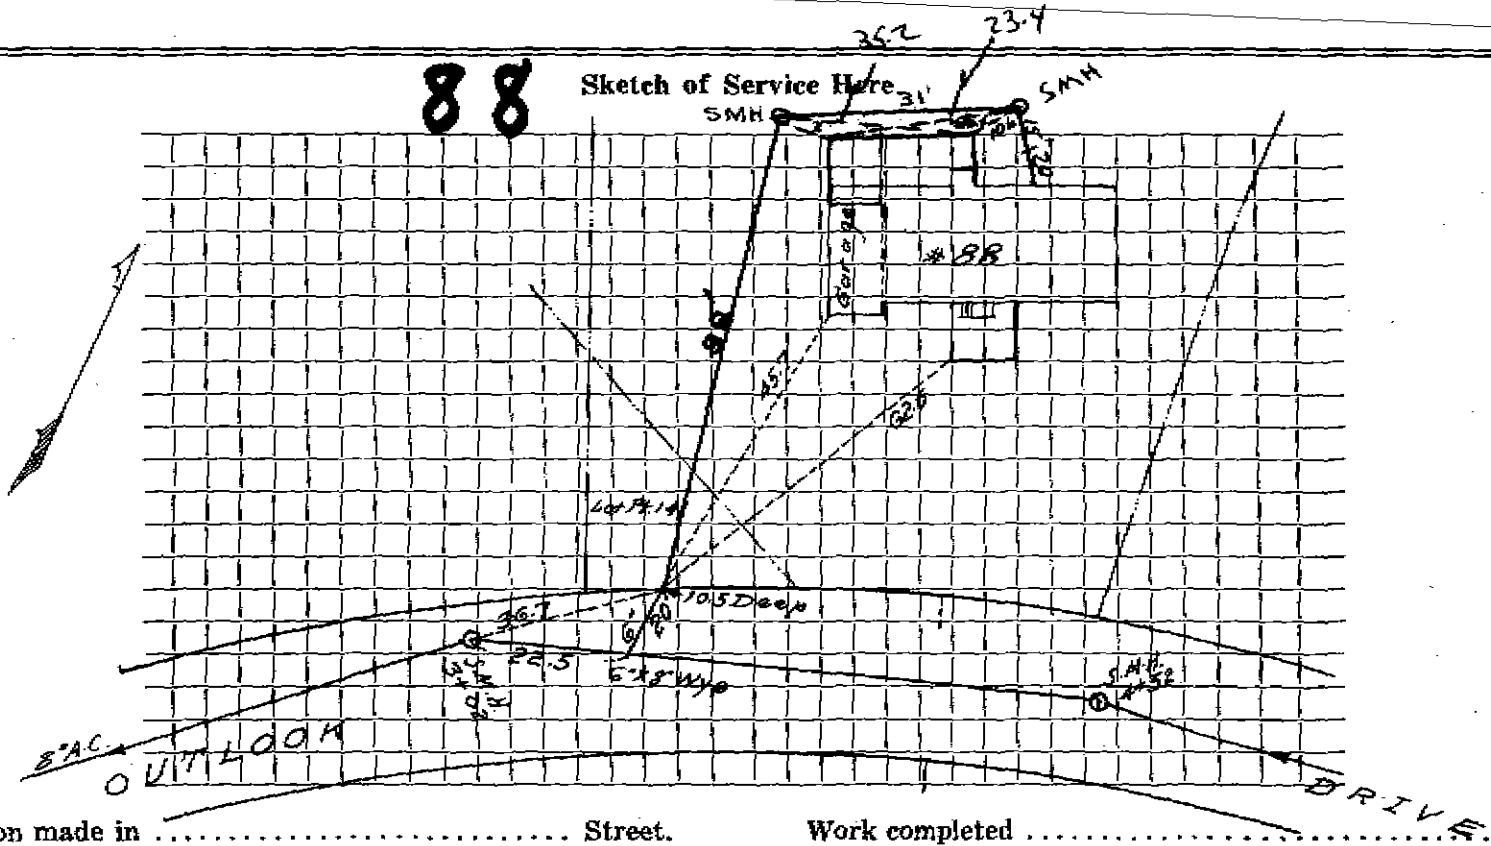

Connection made in Street. Work completed DRIVE

Remarks:

.....

.....