

Name

Service No.

Address 91 OutTeek DR

Location

Kind of Pipe

Size

Size of Main

Repair--Renewal--New Service


Location

Date	Material	Amount	Total	Date	Amount
7/13/94	4" PVC				
43'	6" PVC				
	4x6 Fence				
	6" x 6" Fence				

DATE _____

TOWN OF LEXINGTON — BOARD OF PUBLIC WORKS
SEWER DIVISION

Sketch of Service Here

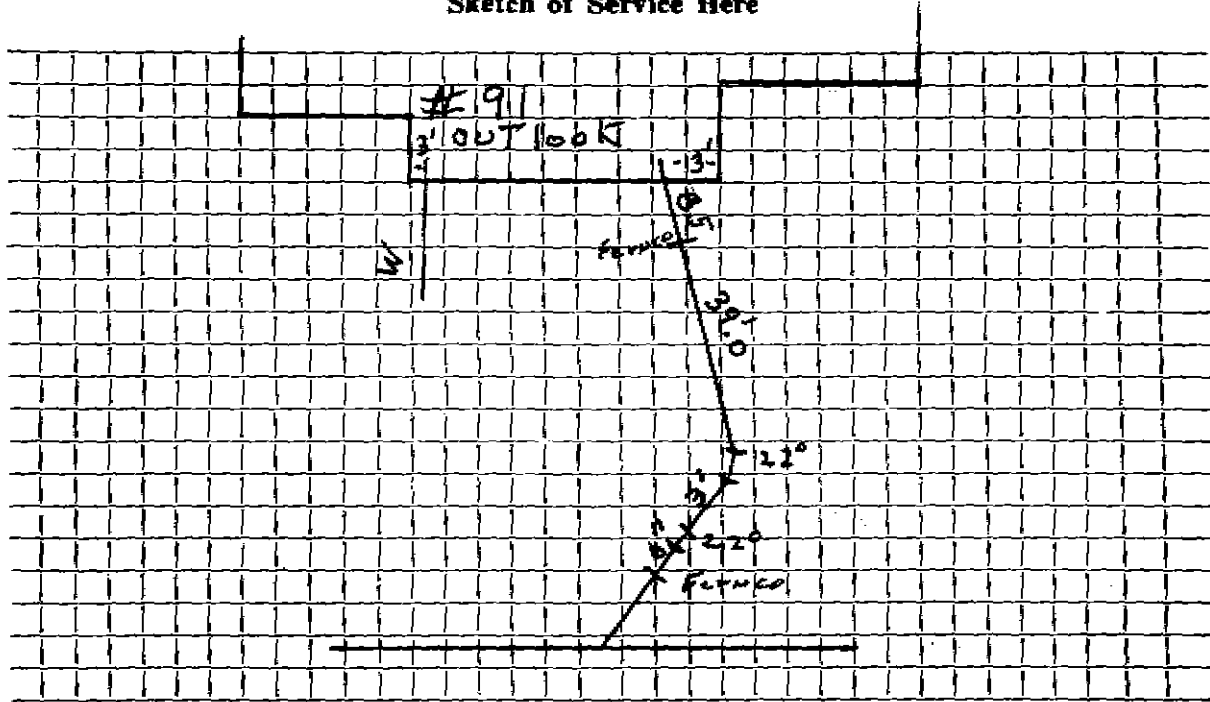

Connection made in Street. Work completed

Remarks:
.....
.....