

Name Chris Theodore

Service No. 35

Address 93 Outlook Dr.

93 Outlook Drive

Location Lot 138 & Pt. 139

Kind of Pipe

Size 6"

Size of Main 8"

Repair—Renewal—New Service

Valve # 2835


Location OCT 25 1976

Date		Material	Amount		Total	Date	Amount
1971	201	6" A.C. transit pipe @ 7.50	150	00		6-2-76 1971	150.00
						20' 6" Transite	

DATE _____

TOWN OF LEXINGTON — BOARD OF PUBLIC WORKS
SEWER DIVISION

Sketch of Service Here **93**

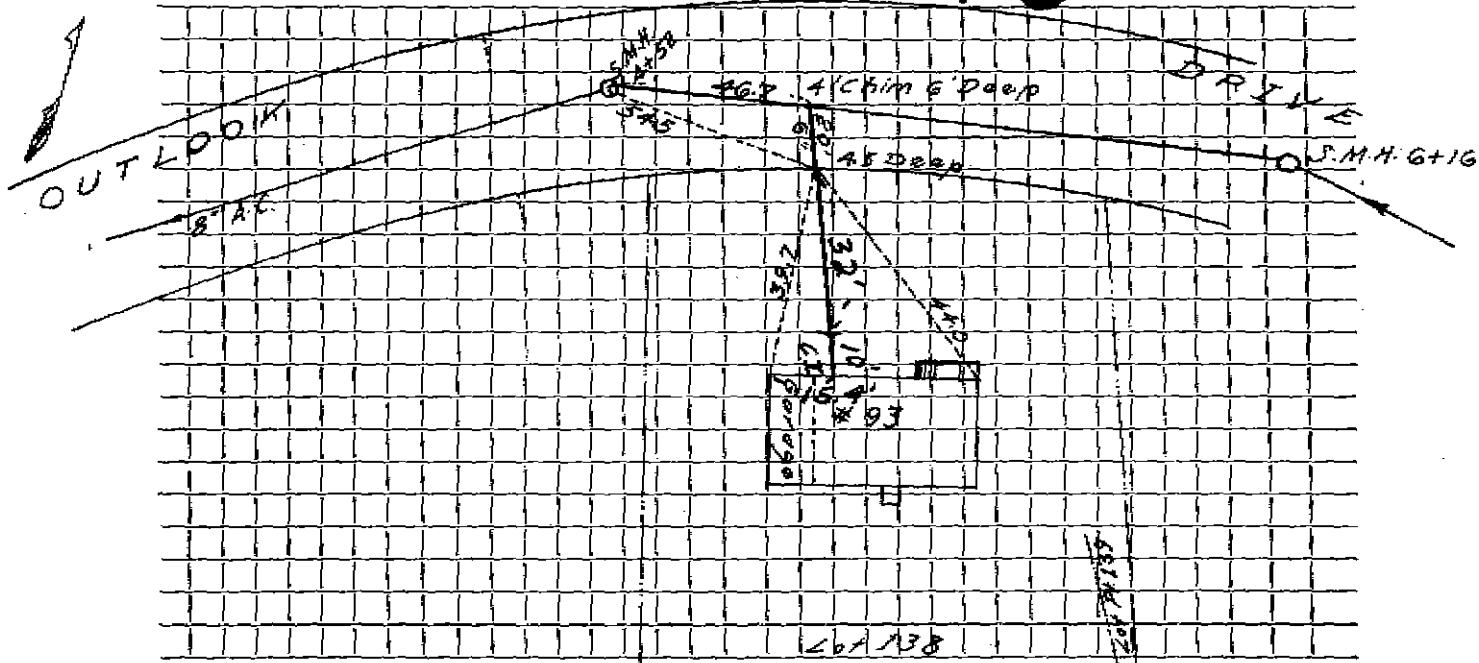

Connection made in Street. Work completed

Remarks:

.....

.....