


DATE _____

TOWN OF LEXINGTON — BOARD OF PUBLIC WORKS

SEWER DIVISION

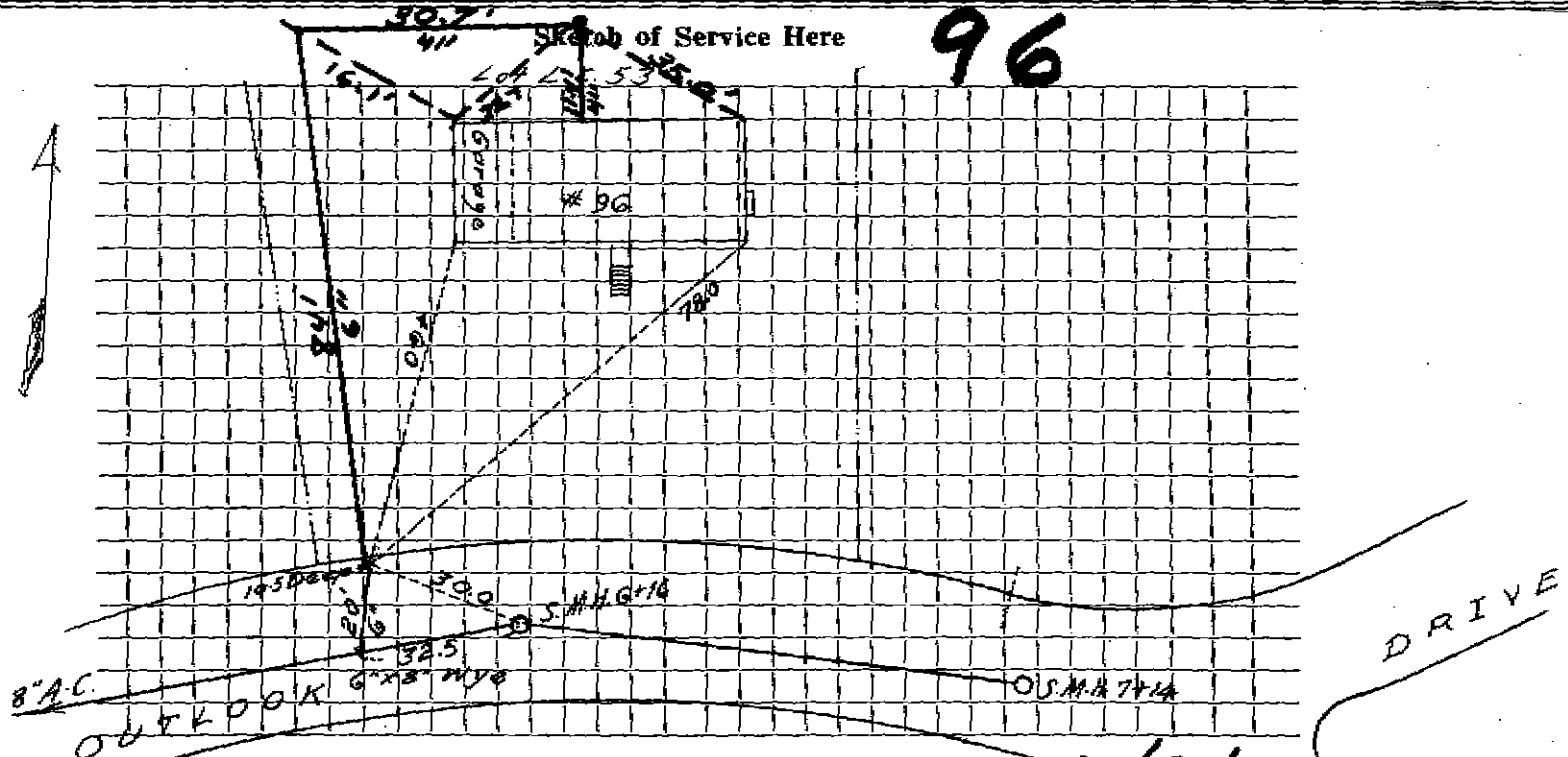

Connection made in 9.6 OUTLOOK DR Street.

Work completed 8/7/74

Remarks:

.....

.....