

DATE _____


TOWN OF LEXINGTON — BOARD OF PUBLIC WORKS

SEWER DIVISION

Sketch of Service Here

98

Lot L.C. 52

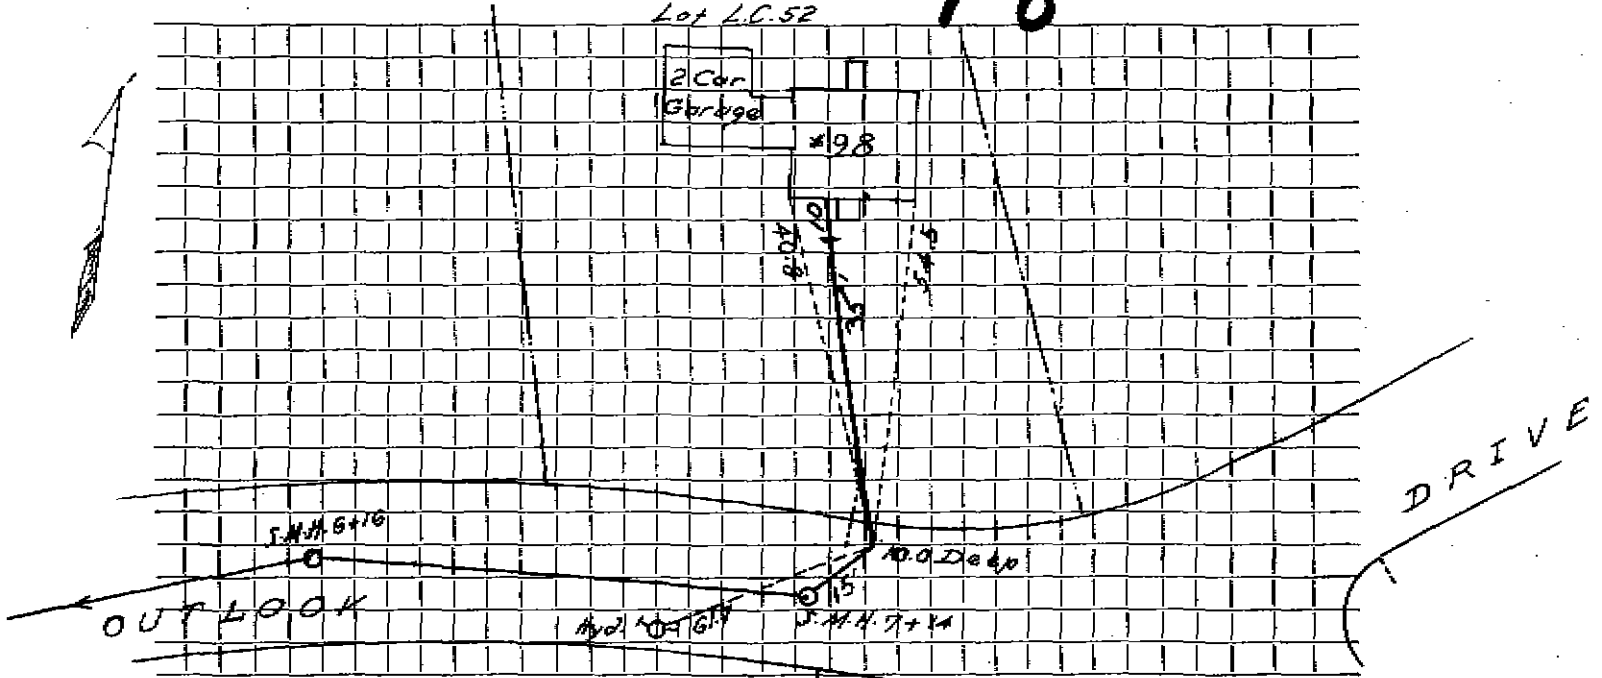

Connection made in Street. Work completed

Remarks:

.....