

Name Leeland Construction Company

Service No. 79

Address 10 Oxbow Road Lexington 73, Massachusetts

10 Oxbow Rd.

Location

Kind of Pipe

Size 6"

Size of Main 8"

~~XXXXXXXXXX~~ New ServiceLocation *Comm 8-3-59*

Date	Material	Amount	Total	Date		Amount
7/30/58	30' 6" Transite Pipe @ 70		21 00	6-9-59	<i>Deposit</i>	250 00
	1 90 Degree 6" Transite Pipe		5 29	8-3-59	<i>Retain</i>	124 48
	1 6" Transite Adapter		1 90			125 52
			28 19			
Installed By Contractor: Bill when Connected						
6-11-59	Labor	42.21				
	10% O.H.	4.22	46.43			
	52' 6" Transite pipe @.70		36.40			
	2 hrs. Town Shovel @6.50		13.00			
	2 hrs. Trucking @.75		1.50			
			125.52			
	<b>Labor</b>					

# TOWN OF LEXINGTON—DEPT. OF PUBLIC WORKS

## SEWER DIVISION

DATE.....

NO. ....


The undersigned applies for the construction of a particular sewer connecting No.....  
 Street and hereby agrees to comply with the Rules and Regulations governing the construction and use of Particular  
 Sewers, as now or at any future time established by the Board of Selectmen.

Am't of estimate \$.....

Am't Paid \$.....

..... Owner

Sketch of Service Here **10**

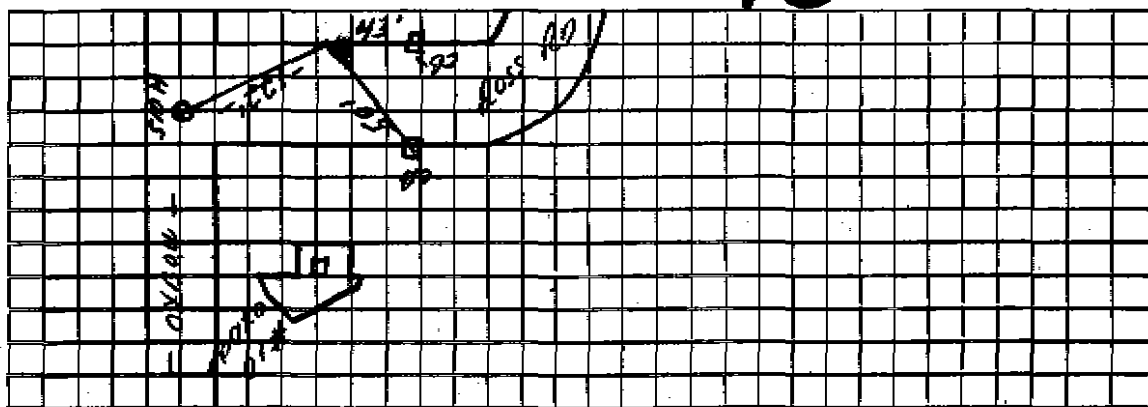

Connection made in..... Street..... Work completed..... 19..

Remarks: CONNECTION ON ROSS RD WATER SERVICE IS ON TOP OF SEWER  
 IS A TEE ON CHIMNEY - TEE IS FOR 10 OXBOW + 11 ROSS RD