

Name Leeland Const.

Service No. 214

Address 12 Oxbow Road Lexington 73, Massachusetts

Location

Kind of Pipe

Size 6"

Size of Main 8"

X ~~XXXXXXXXXXXX~~ New ServiceLocation *Ann 3-16-59*

Date	Material	Amount	Total	Date	Amount
8/7/58	30' 6" Transite Pipe @ 70		21 00	11-14-58	100 00
	1 6" 90 Degree Transite Elbow		5 29	3-16-59	13 64
	1 6" Transite Adapter		1 90		86 36
	1 22½ Degree Transite Bend		2 24		
			30 43		
Installed By Contractor Service to Curb. Bill when Connected					
12-1-58	Labor	22.25			
	10% O.H.	2.23	24.48		
	20' 6" Transite pipe @.70		14.00		
	2 11½° Transite Bends @ 5.10		10.20		
	1 hr. Town Shovel @ 6.50		6.50	1-19-73	15' from house
	1 hr. Trucking @.75		.75		
	Labor		86.36		
5-14-73	Repair				
	1 6"X2' Transite				Applied to S/W #213 9050
	1 6"X3' Nipple				" " W/C #215 314
	1 6"X4' DONUT				

TOWN OF LEXINGTON—DEPT. OF PUBLIC WORKS
SEWER DIVISION

DATE.....

NO.....


The undersigned applies for the construction of a particular sewer connecting No.....
Street and hereby agrees to comply with the Rules and Regulations governing the construction and use of Particular
Sewers, as now or at any future time established by the Board of Selectmen.

Am't of estimate \$.....

Am't Paid \$.....

..... Owner

Sketch of Service Here

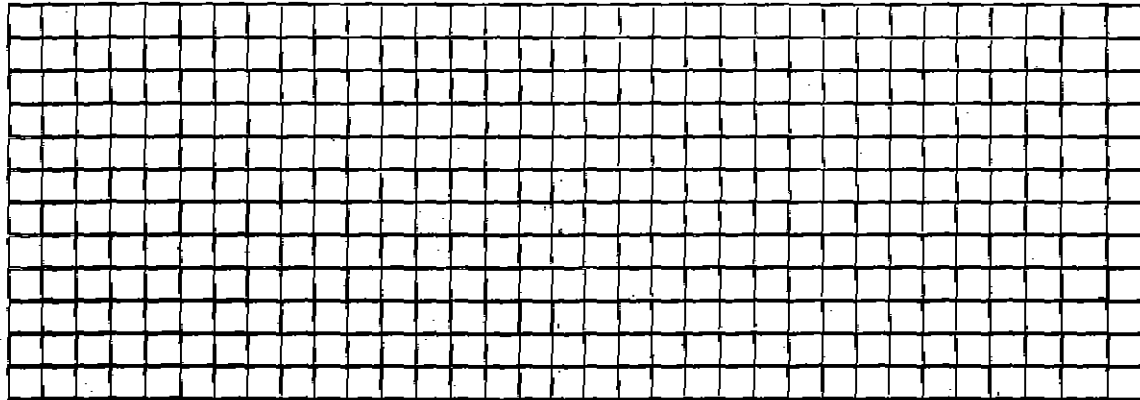

Connection made in..... Street. Work completed.....19..

Remarks: