

Name **Leeland Construction Company**

Service No. **134**

Address **17 Oxbow Road**

17 Oxbow Rd.

Location

Comed 10-14-58

Kind of Pipe

Size **6"**

Size of Main **8"**

~~Repair/Replace~~ **New Service**

Location

Date	Material	Amount	Total	Date	Amount
3-7-58	60' 6" Transite Pipe @.70		42.00		<i>Deposit</i> 50.00
	1 11 1/4" Transite Bend		5.10	<i>10-14-58</i>	<i>Refund</i> 2.90
			47.10		47.10
	Repair (Valeri #3606)				
9-30-80	10' 6" Transite pipe				
	(Removed & Replaced 20' out from house)				
	Labor			<i>12-28-78</i>	<i>Sold</i>

TOWN OF LEXINGTON—DEPT. OF PUBLIC WORKS
SEWER DIVISION

DATE.....

NO.


The undersigned applies for the construction of a particular sewer connecting No.....
Street and hereby agrees to comply with the Rules and Regulations governing the construction and use of Particular
Sewers, as now or at any future time established by the Board of Selectmen.

Am't of estimate \$.....

Am't Paid \$.....

..... Owner

Sketch of Service Here

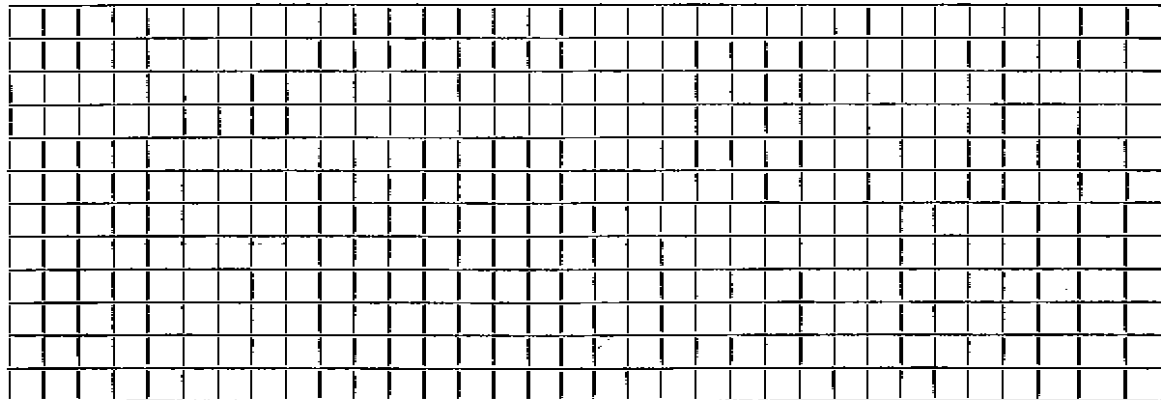

Connection made in..... Street.

Work completed..... 19..

Remarks: