

Name Leeland Const. Co.

Service No. 202

Address 18 Oxbow Road

18 Oxbow Rd.

Location

Kind of Pipe

Size 6"

Size of Main 8"

~~Repair~~ ~~Retard~~ New Service

Location *Comp 12-31-59*


Date	Material	Amount	Total	Date	Amount
-59	Labor	8 11		11-14-59	Deposit 150.00
	10% O. H.	81	8 92	12-31-59	Retard 65.60
26'	6" Transite pipe @.70		18 20		84.40
1	22 1/2" Elbow		2 21		
1	22 1/2" Bend		6 21		
1	Hr. Trucking		75		
			36 32		
	BILL WHEN CONNECTED				
6-59	Labor	17.57			
	10% O.H.	1.76	19.33		
40'	6" Transite pipe @.70		28.00		
1	hr. Trucking @.75		.75		
			84.40		

DATE _____

TOWN OF LEXINGTON — BOARD OF PUBLIC WORKS

SEWER DIVISION

Sketch of Service Here

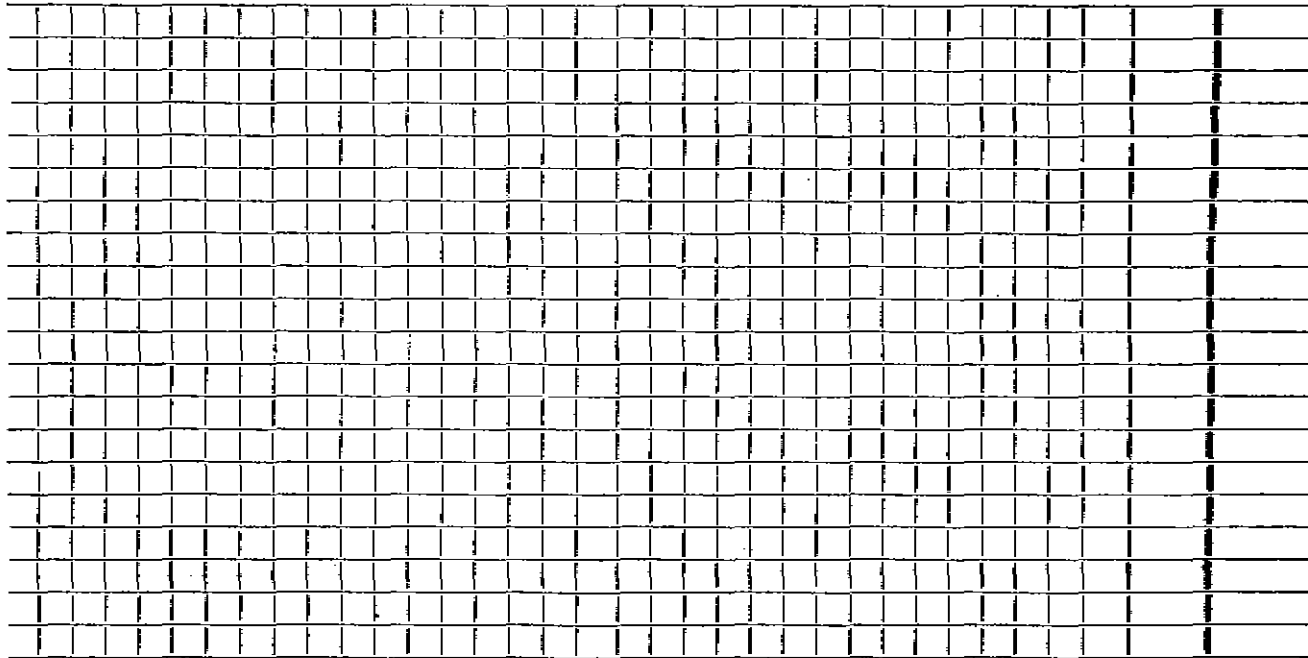

Connection made in Street. Work completed

Remarks:
.....
.....