

Name Leeland Const.

Service No. 119

Address 19 Oxbow Road

Location

19 Oxbow Rd.

Kind of Pipe

Size 6"

Size of Main 8"

~~REPAIR~~ ~~REPAIR~~ ~~REPAIR~~ New Service

Location Cam 8-22-60


Date	Material	Amount	Total	Date	Amount
5-59	Labor	8 11		7-7-60	Deposit 150 00
	10% O. H.	81	8 92	8-22-60	Refund 52 80
26'	6" Transite pipe @.70		18 20		97 20
1	22 1/2° Elbow		2 24		
1	22 1/2° Bend		6 21		
1	Hr. Trucking		75		
			36 32		
	BILL WHEN CONNECTED				
1-60	Labor	32 04			
	10% O. H.	3 20	35 20		
30'	6" Transite pipe @78		23 40		
1	6" 11 1/2° Transite Elbow		2 24		
			97 20		
				5-17-81	Root 25' out from house
				7-2-75	Roots

DATE _____

TOWN OF LEXINGTON — BOARD OF PUBLIC WORKS
SEWER DIVISION

Sketch of Service Here

19

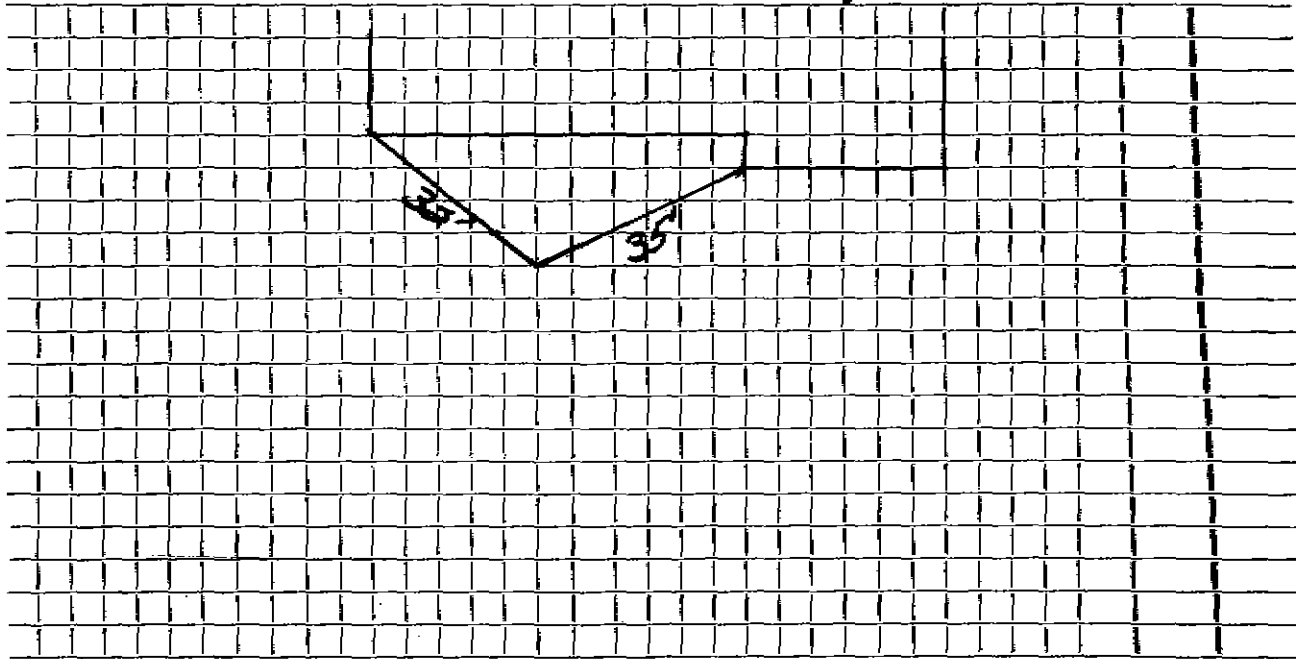

Connection made in Street. Work completed

Remarks:

.....

.....