

Name

Service No.

Address 2 OXBOW

MCLAUGHLIN

Location

Kind of Pipe

Size

Size of Main

~~Repair~~—Renewal—New Service

Location

Date

Material

Amount

Total

Date

Amount

1/2017

6" SDR


6" CLEAN OUT
- 6" CAP
- 6" SDR RISER
- 6" WYCKOFF

6" x 6" FURNACE

DATE 1/9/2017

TOWN OF LEXINGTON — BOARD OF PUBLIC WORKS
SEWER DIVISION

Sketch of Service Here

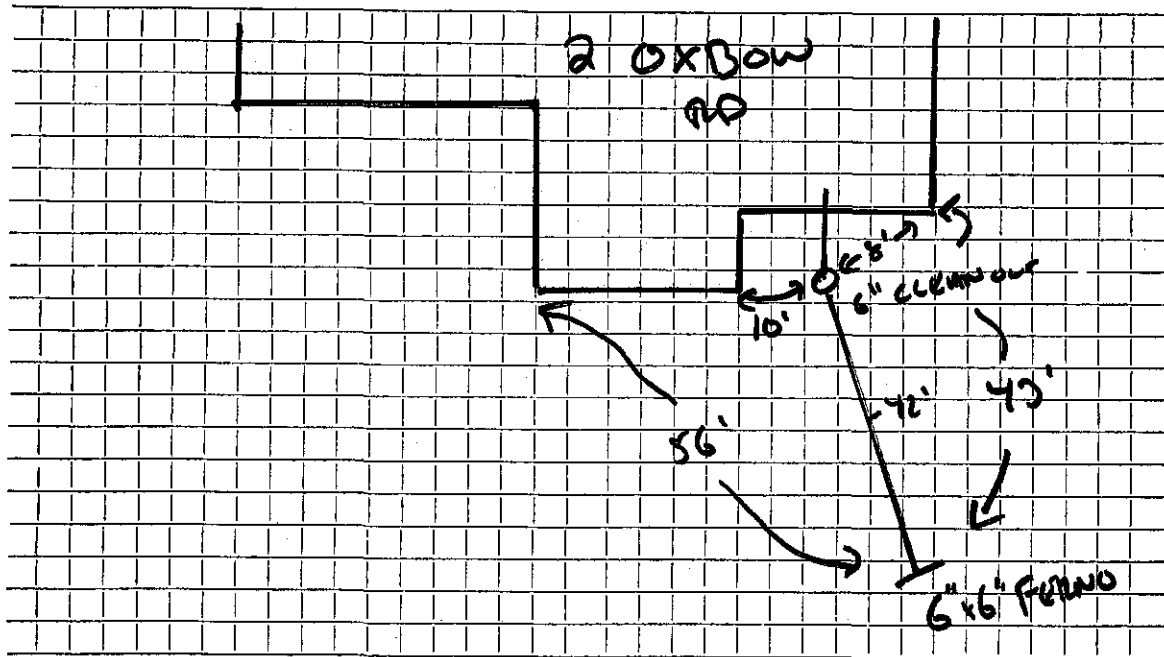

Connection made in OXBOW Street. Work completed MCLAUGHLIN

Remarks: REPAIR, REAR CO