

Name **Lealand Const. Co.**

Service No. **120**

Address **21 Oxbow Road**

21 Oxbow Rd.

Location

Kind of Pipe

Size **6"**

Size of Main **8"**

~~Repair Renewal~~ **New Service**

Location

Comm 8-22-60


Date	Material	Amount	Total	Date	Amount
5-59	Labor	8 11		7-7-60	Deposit 150 00
	10% O. H.	81	8 92	8-22-60	Refund 58 16
26'	6" Transite pipe @.70		18 00		91 84
1	22 1/2" Elbow		2 24		
1	22 1/2" Bend		6 21		
1	Hr. Trucking		75		
			36 32		
	BILL WHEN CONNECTED				
26'	6" Transite Pipe @.78		20 28		
1-60	Labor		35 24		
			91 84		

DATE _____

TOWN OF LEXINGTON — BOARD OF PUBLIC WORKS
SEWER DIVISION

Sketch of Service Here

21

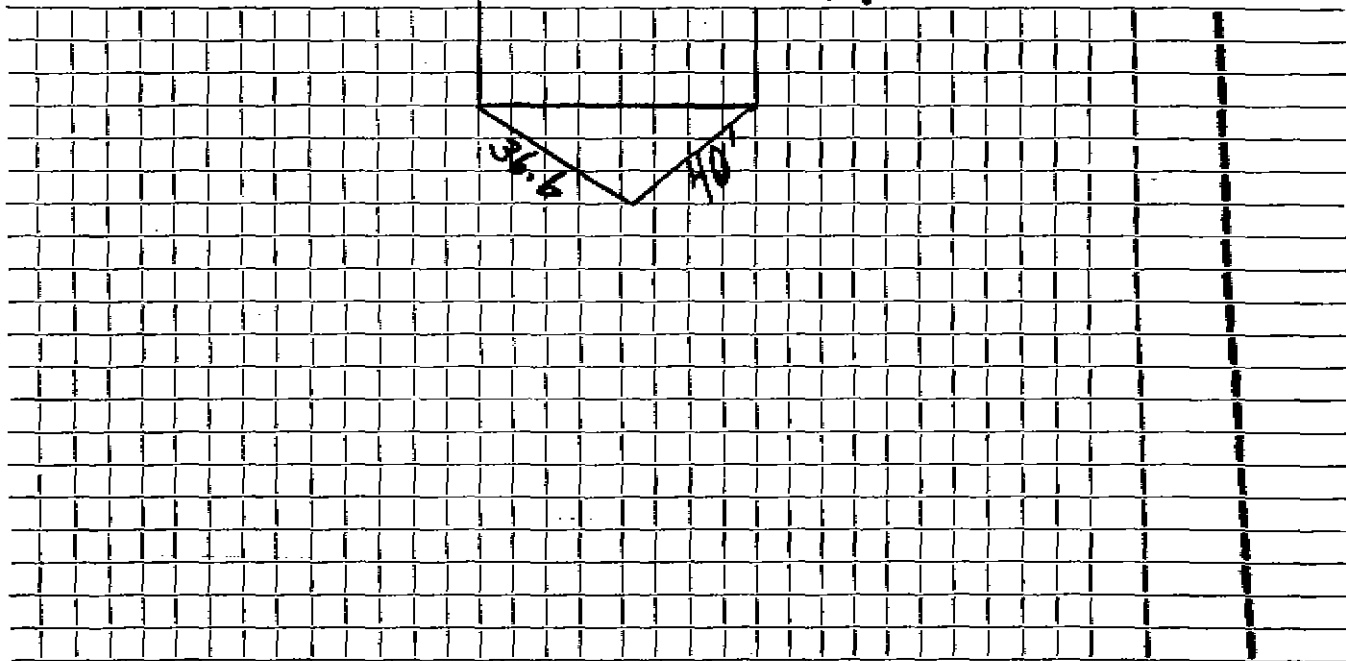

Connection made in Street. Work completed

Remarks:

.....
.....