

Name **Leeland Const. Co.**

Service No. **98**

Address **23 Oxbow Road**

**23 Oxbow Rd.**

Location

Kind of Pipe

Size **6"**

Size of Main **8"**

~~REPAIR~~ ~~RENEWAL~~ **New Service**


Location **Comm 8-22-60**

Date	Material	Amount	Total	Date	Amount
-59	Labor	8 11		6-9-60	Deposit 150 00
	10% O. H.	81	8 92	8-22-60	Refund 48 68
	26' 6" Transite Pipe @.70		18 20		101 38
	1 Hr. Trucking @.75		75		
			27 87		
	<b>BILL WHEN CONNECTED</b>				
2-60	Labor	25 19			
	10% O.H.	2 52	27 71		
	52' 6" Transite pipe @78		40 56		
	1 6" Transite Elbow		2 24		
	1 Hr Trucking @3.00		3 00		
			101 38		

DATE \_\_\_\_\_

TOWN OF LEXINGTON — BOARD OF PUBLIC WORKS  
SEWER DIVISION

Sketch of Service Here **23**

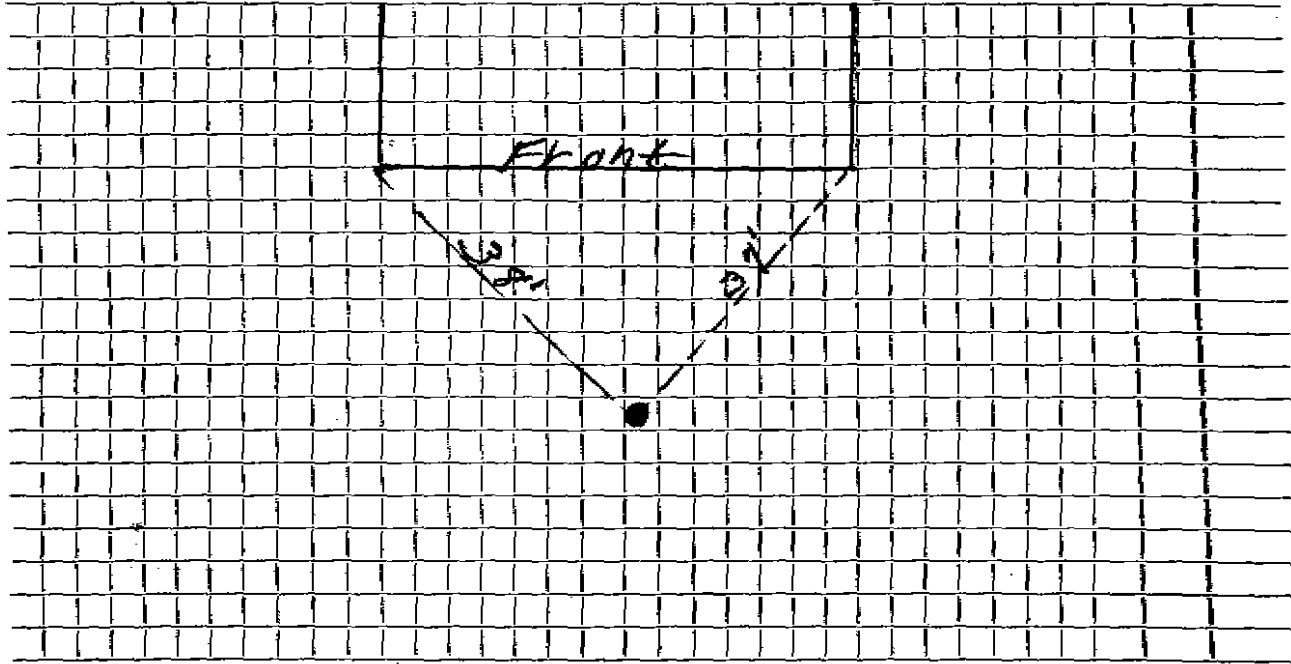

Connection made in ..... Street. Work completed .....

Remarks: .....

.....

.....