


TOWN OF LEXINGTON — BOARD OF PUBLIC WORKS

SEWER DIVISION

DATE 4/30/21

Sketch of Service Here

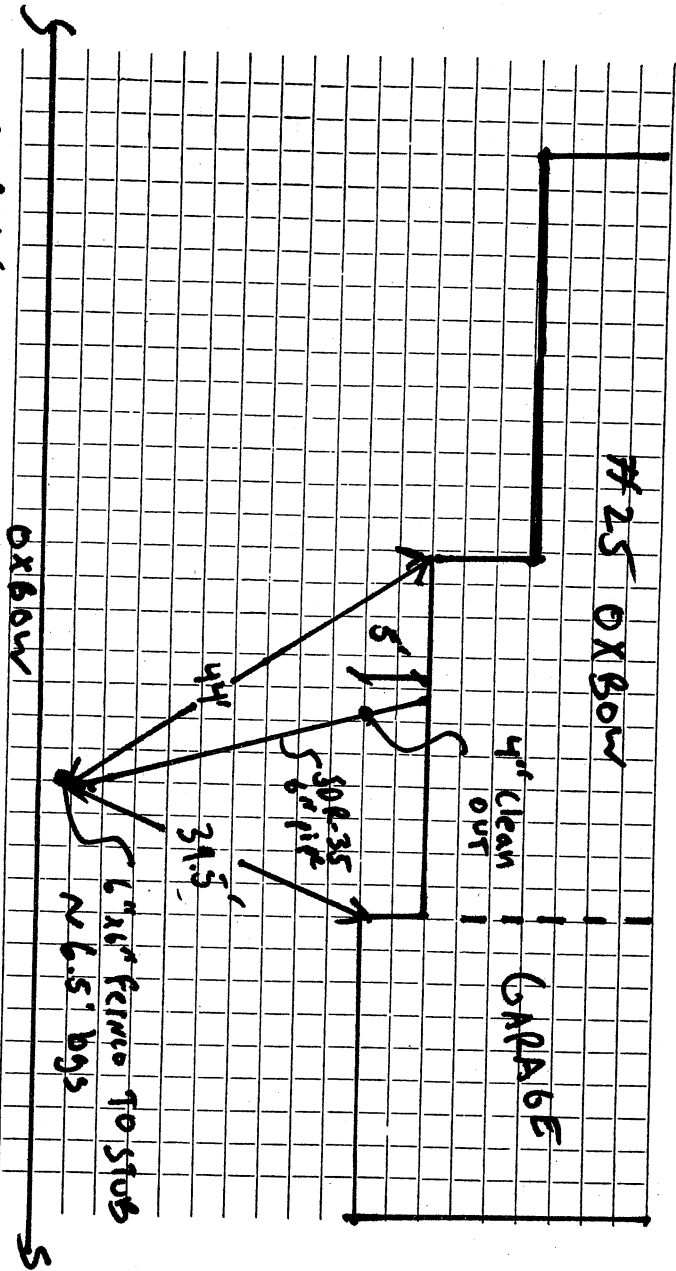

Connection made in OX Bow

Street

Work completed

Remarks: Renewal

6" x 6" ferris to stub
N 6.5' bgs

3 A.S.

5' 6" pipe

5'

4" Clean out

#25 OX Bow


OX Bow

DATE _____

TOWN OF LEXINGTON — BOARD OF PUBLIC WORKS
SEWER DIVISION

Sketch of Service Here

25

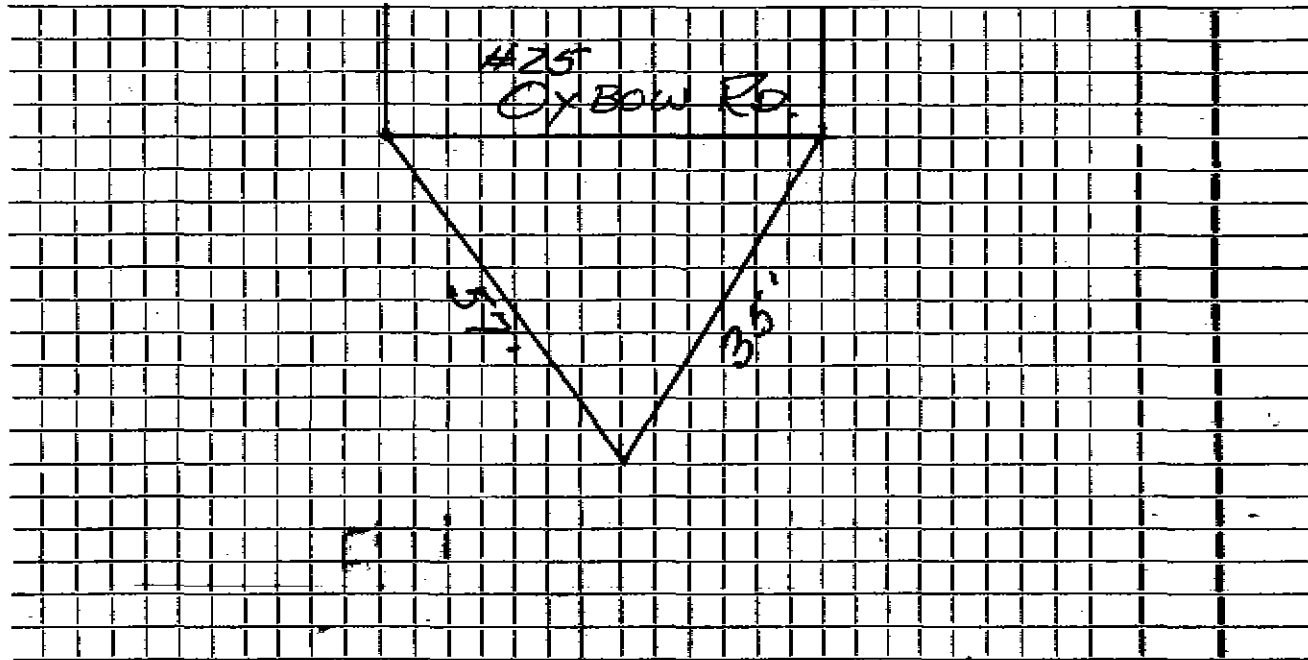

Connection made in Street. Work completed

Remarks:

.....

.....