

Name **Island Const. Co.**

Service No. **98**

Address **28 Oxbow Road**

28 Oxbow Rd.

Location

Kind of Pipe

Size **6"**

Size of Main **8"**

~~SEWER REVISION~~ **New Service**

Location **Quinn 8-22-60**


Date	Material	Amount	Total	Date	Amount
31-59	LABOR		8 11	6-9-60	158.00
	10% O.H.		81	8-22-60	43.26
26'	6" TRANSITE PIPE @.70		18 20		166.74
1	22 1/2" TRANSITE PIPE @.70		2 24		
1	1 1/2" BAND		5 10		
1	Hrs. TRUCKING		75		
			35 21		
	BILL. WHEN CONNECTED				
-60	LABOR	32 04			
	10% O.H.	3 20	35 24		
28'	6" TRANSITE PIPE @78		21 84		
1	22 1/2" TRANSITE BAND		6 21		
1	1 1/2" TRANSITE ELBOW		2 24		
2	Hrs TRUCKING @3.00		6 00		
			106 74		

DATE _____

TOWN OF LEXINGTON — BOARD OF PUBLIC WORKS

SEWER DIVISION

Sketch of Service Here **28**

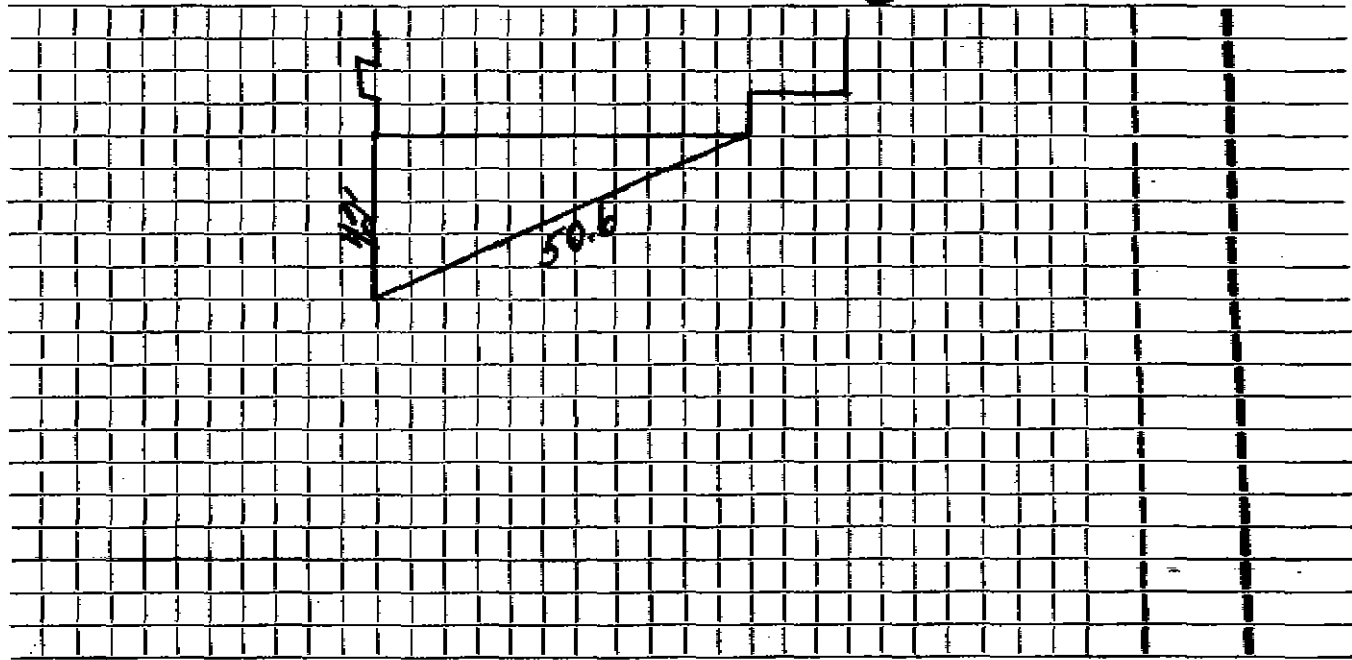

Connection made in Street. Work completed

Remarks:
.....
.....