


TOWN OF LEXINGTON — BOARD OF PUBLIC WORKS

SEWER DIVISION

DATE 4/28/21

Sketch of Service Here

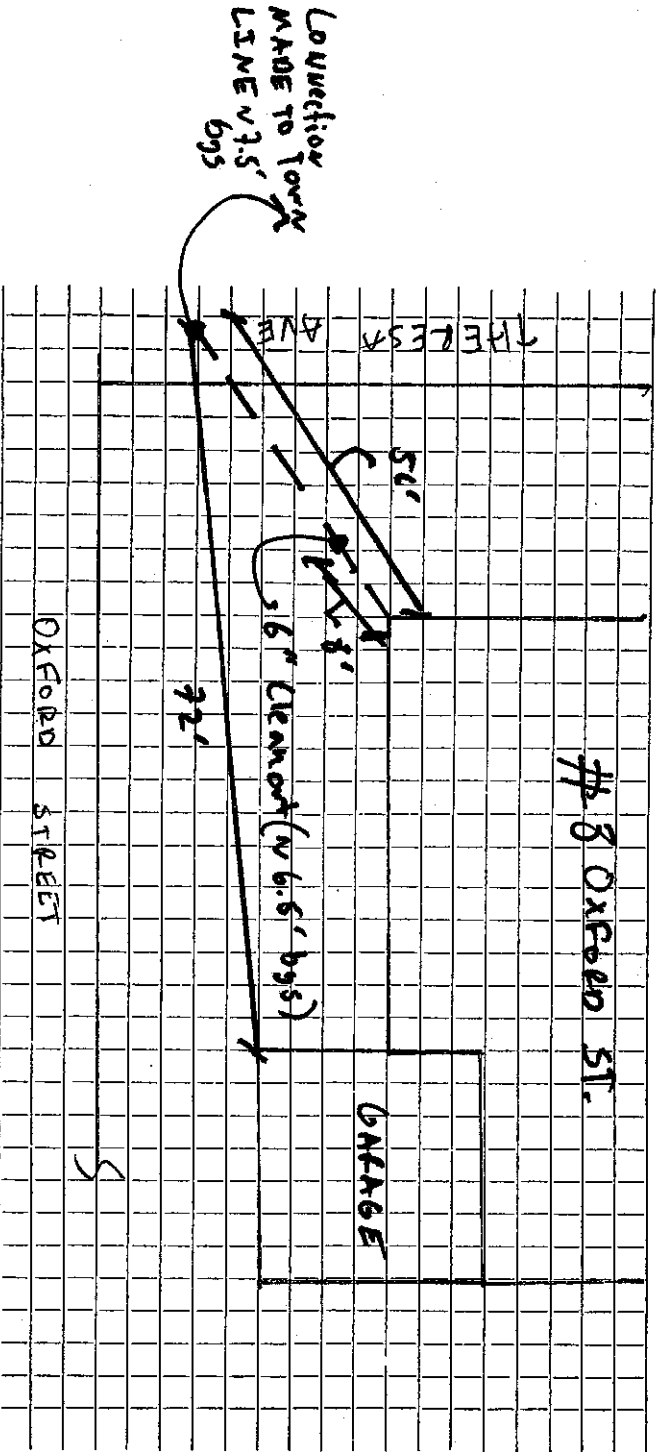

Connection made in Theresa Ave Street Work completed

Remarks: * Connection made to existing cut in town line

