

Name Decatur J. Taylor

Service No. 78

Address 10 Oxford Street

10 Oxford ST.

Location

Comm. 9/30/57

Kind of Pipe

Size 6"

Size of Main

~~Repair~~ ~~Renewal~~ — New Service

Location

Date	Material	Amount	Total	Date	Amount
6/26/57	Labor	68 73		6-11-57	Deposit \$ 125 00
	10% overhead	6 87	75 60	9-30-57	Refund 20 48
	17' - 6" Transite Pipe @ .7020		11 93		\$ 104 52
	4' - 6" V. C. Pipe @ .435		1 74		
	2 hrs. Town Shovel @ 6.50		13 00		
	3 hrs. Trucking @ .75		2 25		
			104 52		
				4-20-06	Plumber hit roots 15-25' out
				5/4/06	Respond + Absence Made Repair From Iron to edge of the Street
	10' 2" Plastic				
	Labor 4" Iron to Plastic Ferncoat				
	Plastic to Transite Ferncoat				

TOWN OF LEXINGTON—DEPT. OF PUBLIC WORKS
SEWER DIVISION

DATE.....

NO.


The undersigned applies for the construction of a particular sewer connecting No.....
Street and hereby agrees to comply with the Rules and Regulations governing the construction and use of Particular
Sewers, as now or at any future time established by the Board of Selectmen.

Am't of estimate \$.....

Am't Paid \$.....

..... Owner

Sketch of Service Here

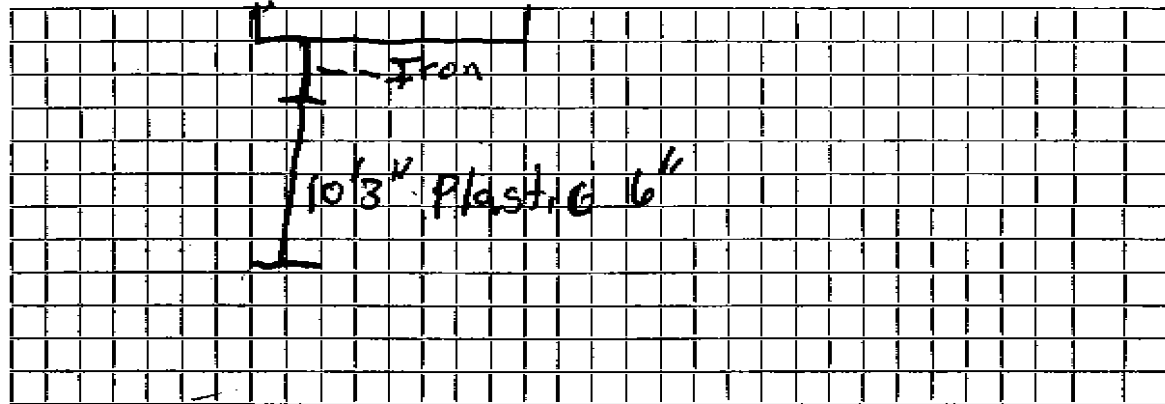

Connection made in..... Street.

Work completed..... 19..

Remarks: