

Name Winsor D. Jellis

Service No. 87

Address 12 Oxford Street

12 Oxford ST.

Location

Kind of Pipe

Size 6"

Size of Main

~~Repair~~ ~~Renewal~~ - New Service

Comm 9-24-56

Location

| Date | Material | Amount | Total | Date | Amount |
|----------------|---------------------------|--------|--------|---------|--|
| August 1, 1956 | Labor | 73 23 | | 7-9-56 | Deposit \$200 00 |
| | 10% overhead | 7 32 | 80 55 | 7-24-56 | Refund \$ 67 50 |
| | 36' 6" Sewer Pipe @ .3645 | | 13 12 | | 13x 50 |
| | Joint compound | | 2 16 | | |
| | 1 6" Elbow | | 1 88 | | |
| | Town Shovel 5 hrs @ 6.50 | | 32.50 | | |
| | 1 hr. trucking @ .75 | | 75 | | |
| | 1 6" 1/8 Bend | | 1 54 | | \$28.41 applied to w.H.C |
| | | | 132.50 | | \$184 |
| | | | | 1-21-98 | Roots 25' out - to be renewed respond |
| | Labor | | | 2001 | REPAIRED 6' 6" PVC |

**TOWN OF LEXINGTON—DEPT. OF PUBLIC WORKS
SEWER DIVISION**

DATE.....

NO.


The undersigned applies for the construction of a particular sewer connecting No.....
Street and hereby agrees to comply with the Rules and Regulations governing the construction and use of Particular
Sewers, as now or at any future time established by the Board of Selectmen.

Am't of estimate \$.....

Am't Paid \$.....

..... Owner

Sketch of Service Here

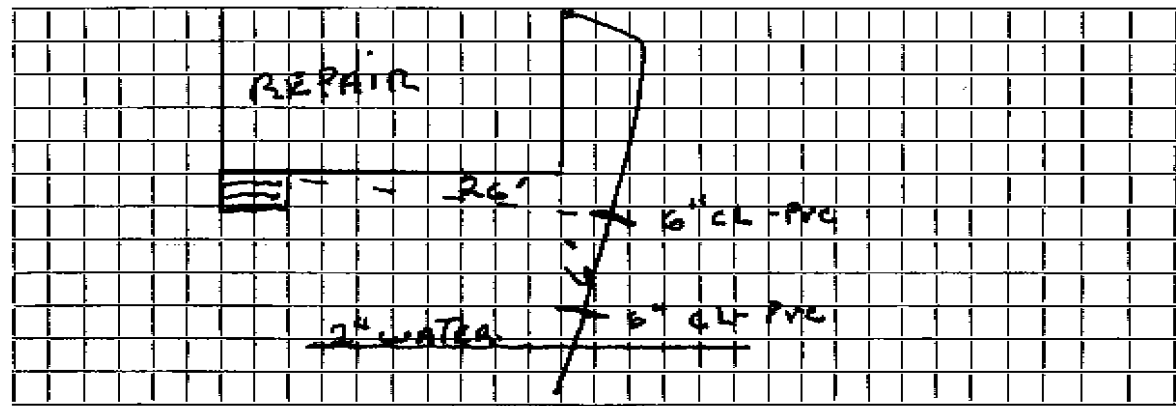

Connection made in..... Street.

Work completed.....19..

Remarks: