


DATE _____

TOWN OF LEXINGTON — BOARD OF PUBLIC WORKS
SEWER DIVISION

Sketch of Service Here

16

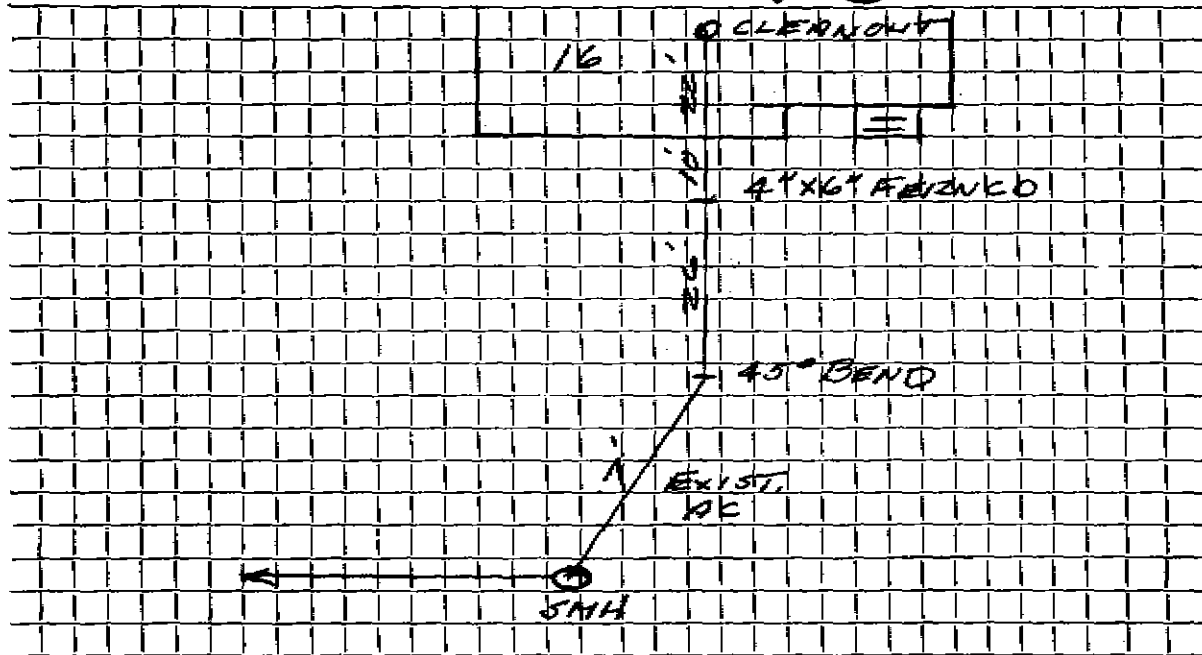

Connection made in OXFORD Street. Work completed

Remarks: CONNECT TO EXIST. AC

22 LF 4" DI UNDER FLOOR TO CLEANOUT