

Name Louis Stoico

Service No.

Address 10 Paddock Lane

10 Paddock Lane

Location

Lot #5

Kind of Pipe


Size 6"

Size of Main 8"

Repair—Renewal—New Service Eagle #913 Dons Gradall Ser. - Permitt #668

Location

Date	Material	Amount	Total	Date	Amount
26/67	39' 6" Transite				
2-13-67	40' 6" Transite pipe				
	10' 4" Cast Iron pipe			6-26-67	
				39' 6" Transite	
				1 6" x 8" Wye	

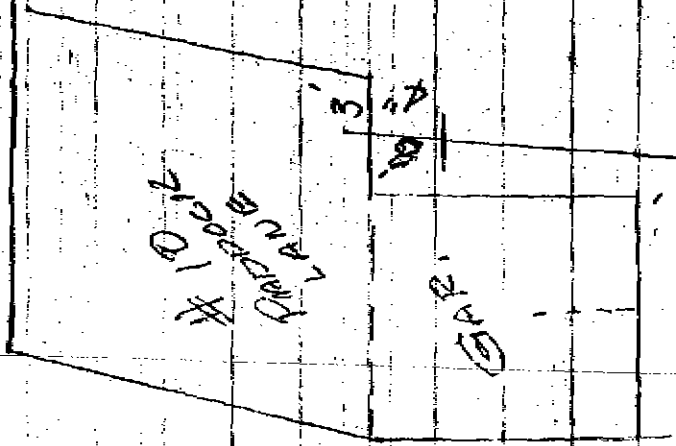

4-19-94

B. MCKEE

8" EEC 4" PVC

50 LF 6" PVC

4" 6" FERRO

2" 6" FERRO

2" 2.5 LF NIPPLE


2" 45° BEND

2" 45° BEND

DATE _____

TOWN OF LEXINGTON — BOARD OF PUBLIC WORKS
SEWER DIVISION

Sketch of Service Here **10**

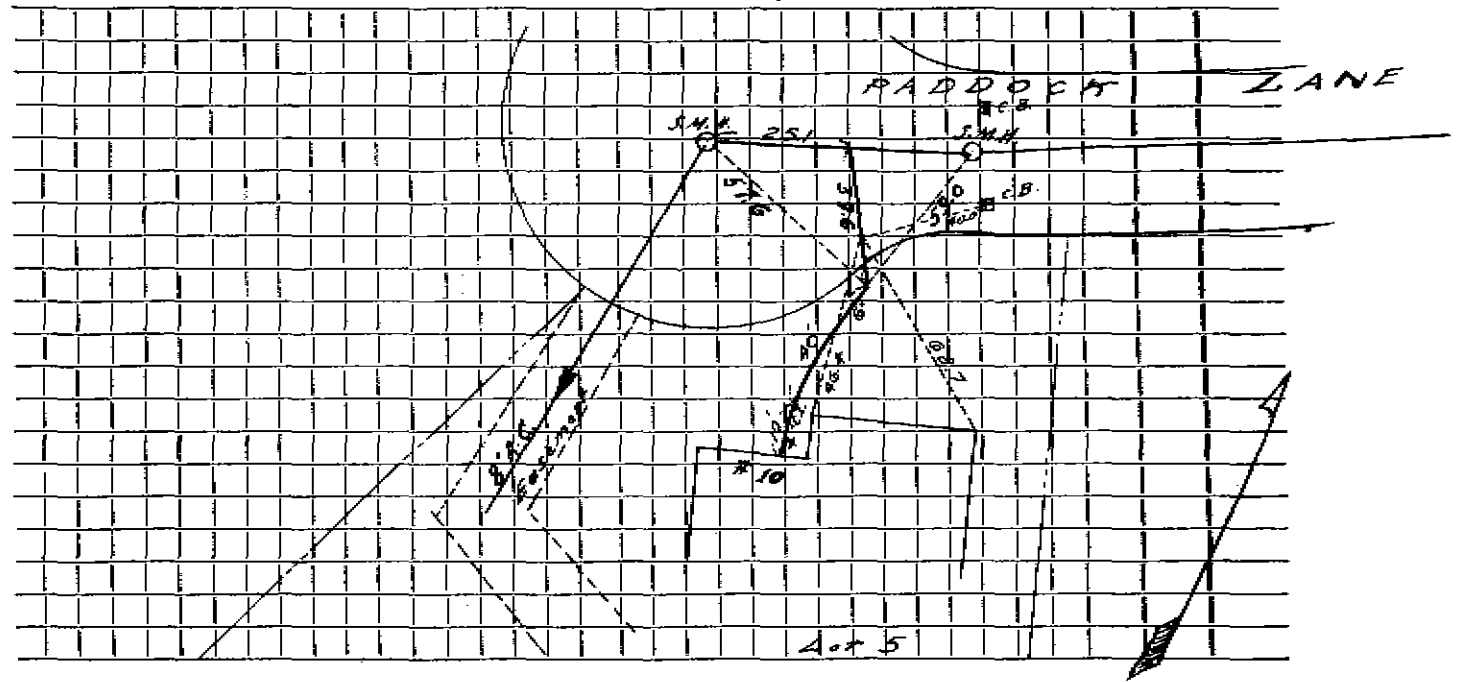

Connection made in Street. Work completed

Remarks:
.....
.....