

Name **Louis Stocio**

Service No.

Address **11 Paddock Lane**

**11 Paddock Lane**

Location **Lot #7**

Kind of Pipe

Size **6"**

Size of Main **8"**

Repair—Renewal—New Service

**Eagle #914**  
**Dons Gradall Ser. Permit #669**

Location


Date	Material	Amount	Total	Date	Amount
<del>6-26-67</del>	<del>62' 6" Transite</del>				
2-14-67	40' 6" Transite pipe				
				6-26-67	
				62' 6" Transite	

DATE \_\_\_\_\_

TOWN OF LEXINGTON — BOARD OF PUBLIC WORKS

SEWER DIVISION

Sketch of Service Here

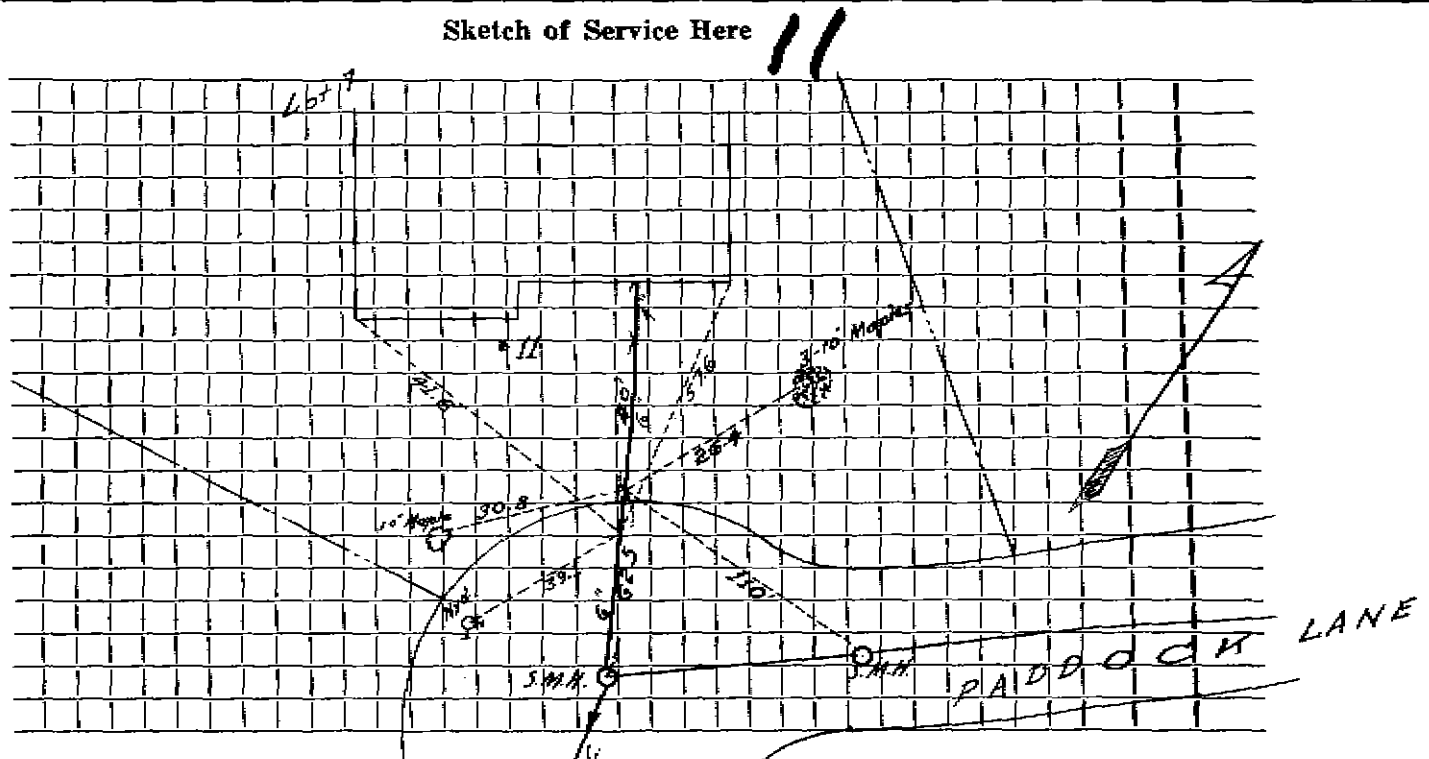

Connection made in ..... Street. Work completed .....

Remarks: .....  
.....  
.....