

Name

Service No.

Address

5 Paddock Lane

Lot #11 5 Paddock Lane

Location

Kind of Pipe

Size 6"

Size of Main 8"

Repair—Renewal—New Service

Don Gradall #663

Location


Date	Material	Amount	Total	Date	Amount	
7-13-67	38' 6" Transite pipe			7-13-67	38' 6" Transite	

DATE _____

TOWN OF LEXINGTON — BOARD OF PUBLIC WORKS
SEWER DIVISION

Sketch of Service Here

5

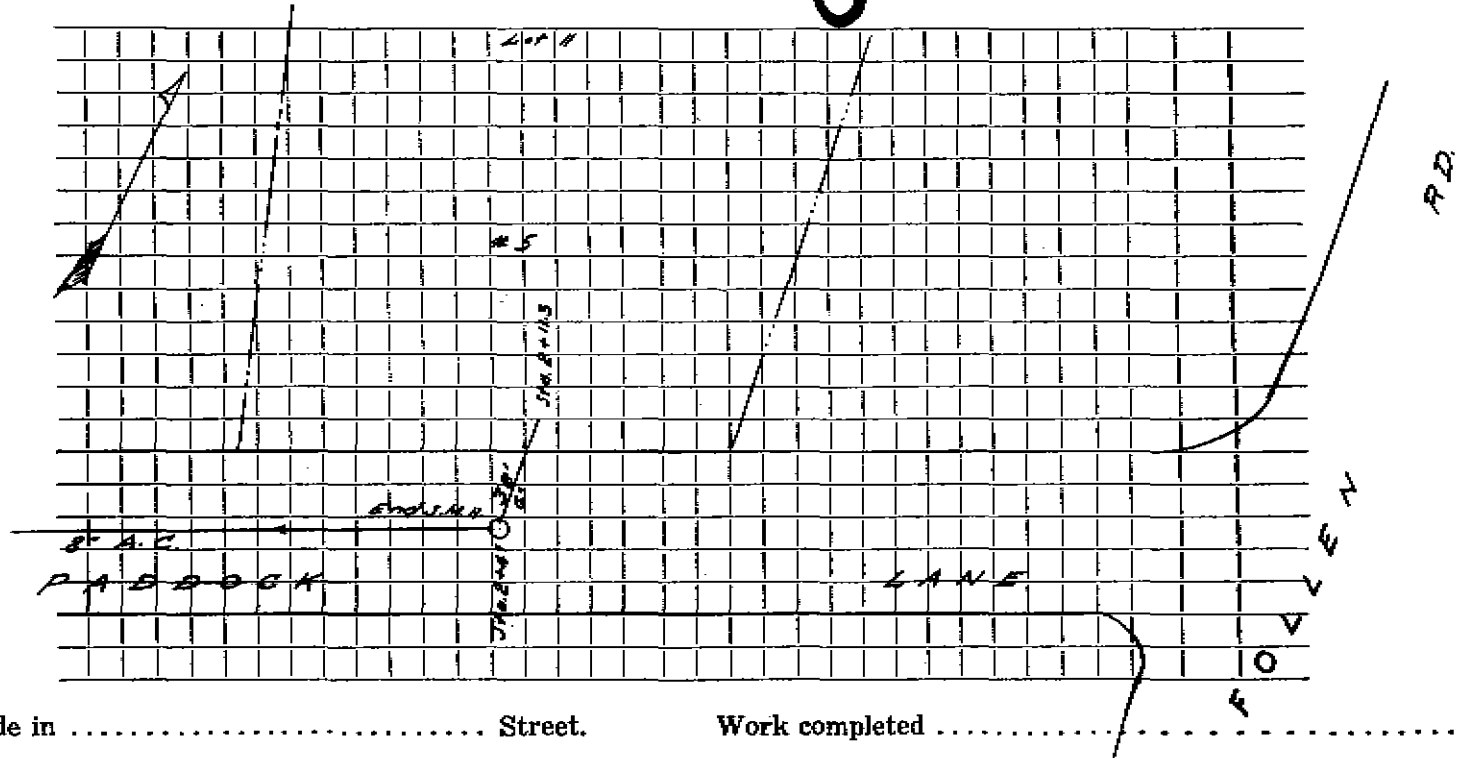

Connection made in Street. Work completed

Remarks:

.....

.....