

Name Louis Stoico

Service No.

Address 6 Paddock Lane

Lot #3 6 Paddock Lane

Location

Kind of Pipe

Size 6"

Size of Main 8"

Repair—Renewal—New Service

Eagle #1059  
Dons Gradall #664

Location

Date		Material	Amount	Total	Date	Amount
<del>7-67</del>	<del>35'</del>	<del>6" Transite pipe</del>				
5-12-68	45'	6" Transite pipe				
	10'	4" Cast Iron			7-7-67	
					35' 6" Transite	
					1 6" x 8" Wye	


DATE \_\_\_\_\_

TOWN OF LEXINGTON — BOARD OF PUBLIC WORKS

SEWER DIVISION

Sketch of Service Here

6

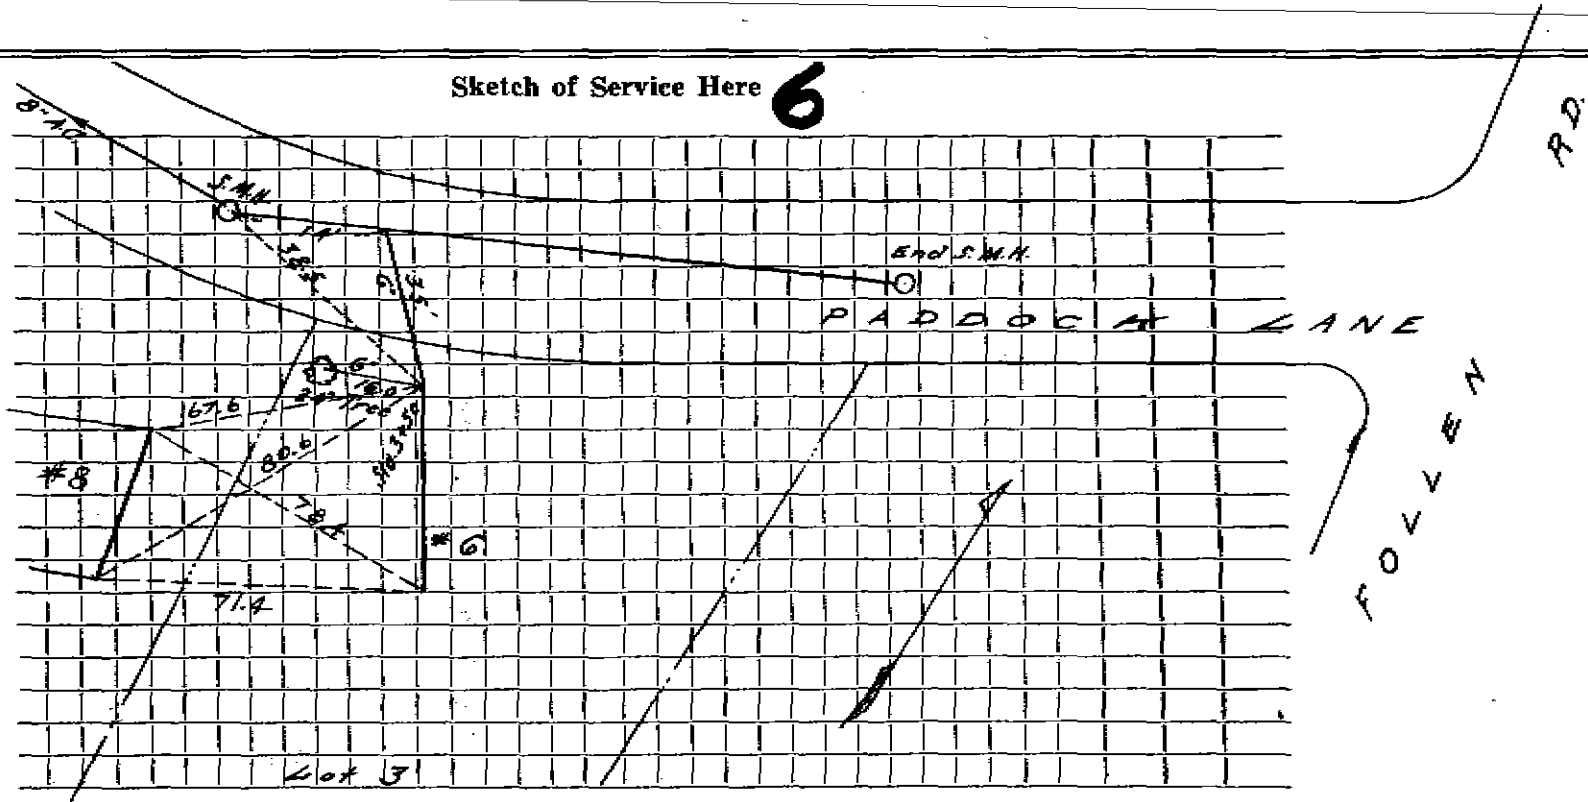

Connection made in ..... Street. Work completed .....

Remarks: .....

.....

.....