

Name

Service No.

Address 7 Paddock Lane

7 Paddock Lane

Location

Kind of Pipe

Size 6"

Size of Main 8"

Repair—Renewal—New Service Don Gradall #665

Location

Date	Material	Amount	Total	Date	Amount
7-13-67	20' 6" Transite pipe				
				7-13-67	
				20' 6" Transite	
				1 6"x8" Wye	


DATE _____

TOWN OF LEXINGTON — BOARD OF PUBLIC WORKS

SEWER DIVISION

Sketch of Service Here

7

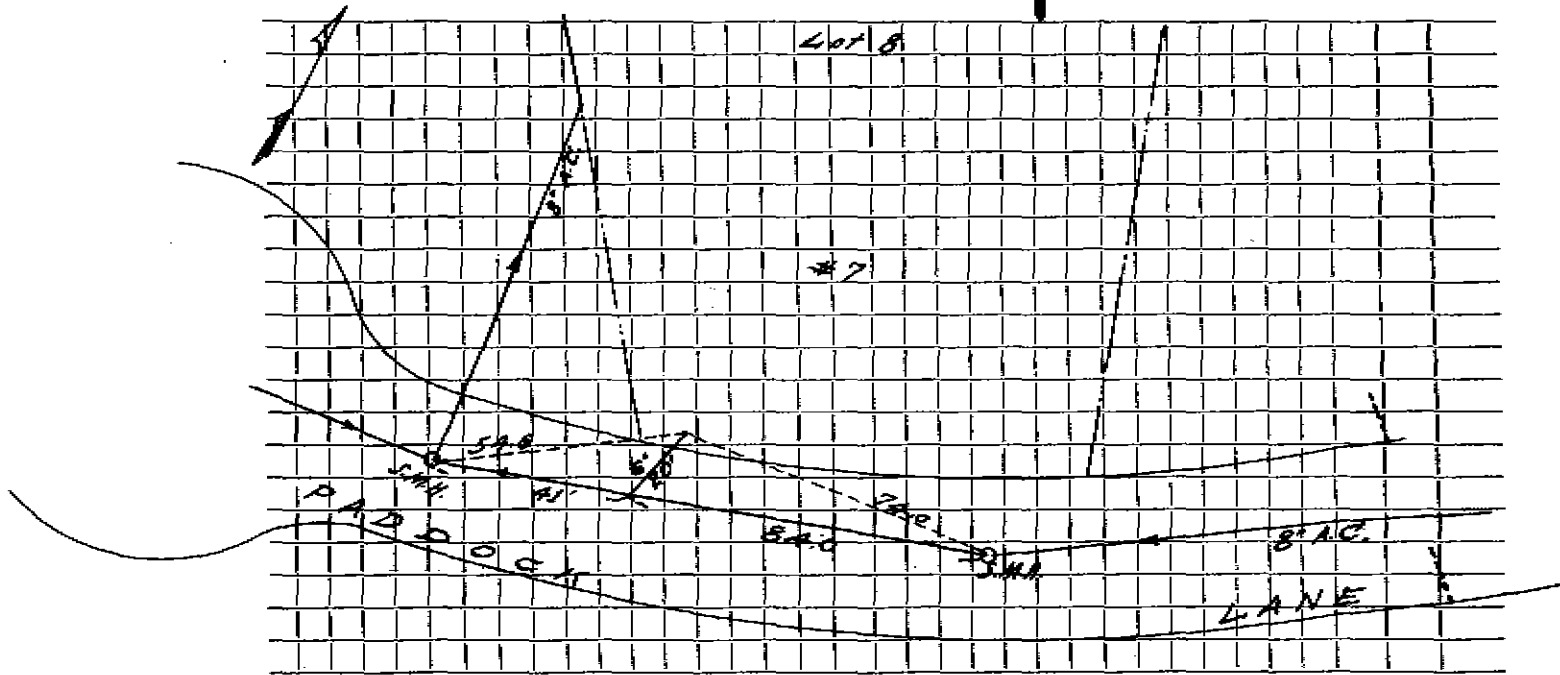

Connection made in Street. Work completed

Remarks:
.....
.....