




DATE SEPT 23, 1983

TOWN OF LEXINGTON — BOARD OF PUBLIC WORKS  
SEWER DIVISION

Sketch of Service Here

9

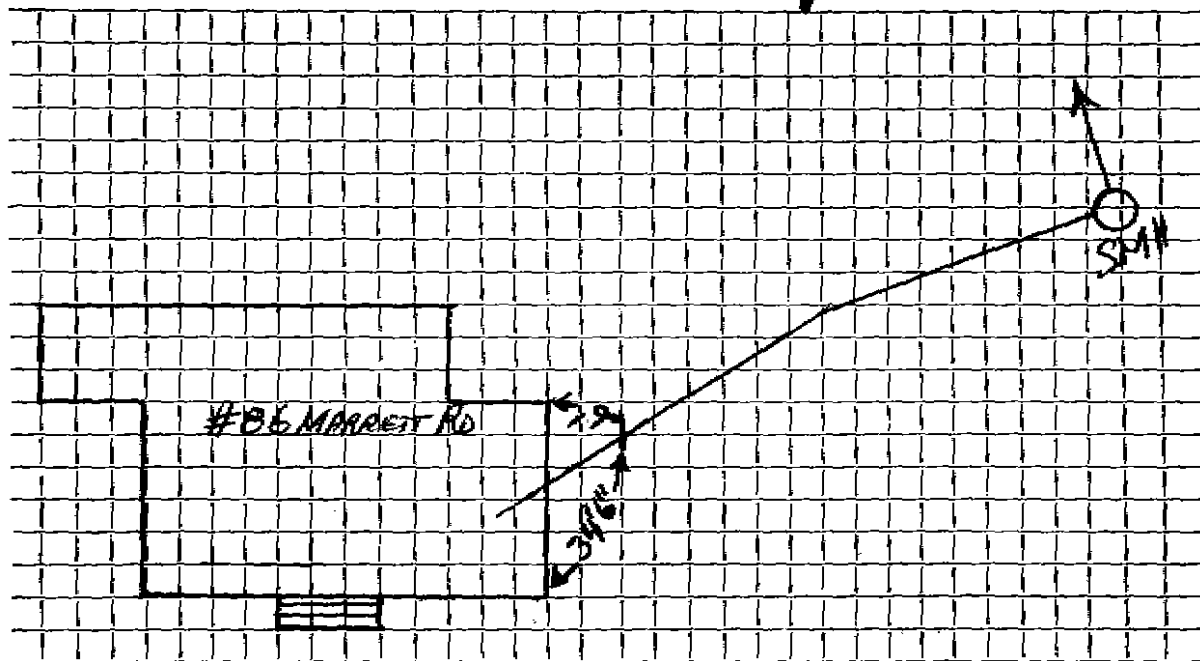

Connection made in \_\_\_\_\_ Street.

Work completed SEPT. 1983

Remarks: CONNECTION MADE IN MANHOLE LOCATED IN BACK YARD OF  
# 11 PADDOCK LANE