

Service No. 206

Name Wm. C. Chamber Estates

Address 1 Page Road

1 Page Road

Kind of Pipe

Size 6"

Size of Main 8"

Repair-Replace-~~...~~-New Service

Location

Area 18-11-R


| Date    | Material                       | Amount | Total | Date     | Amount |
|---------|--------------------------------|--------|-------|----------|--------|
| 1-9-59  | LABOR                          | 14 88  |       | 12-8-60  | 80.00  |
|         | 10% O. & H.<br>OWNER INSTALLED | 1 49   | 16 37 | 12-21-60 | 3.92   |
|         | LABOR FOR SUPERVISION          |        |       |          | 53.03  |
| 2-19-60 | 47' 6" Transits pipe @ .78     |        | 36.66 |          |        |
|         |                                |        | 53.03 |          |        |

Apply C. 17) to W.M.C. # 308

DATE \_\_\_\_\_

**TOWN OF LEXINGTON — BOARD OF PUBLIC WORKS**  
**SEWER DIVISION**

Sketch of Service Here

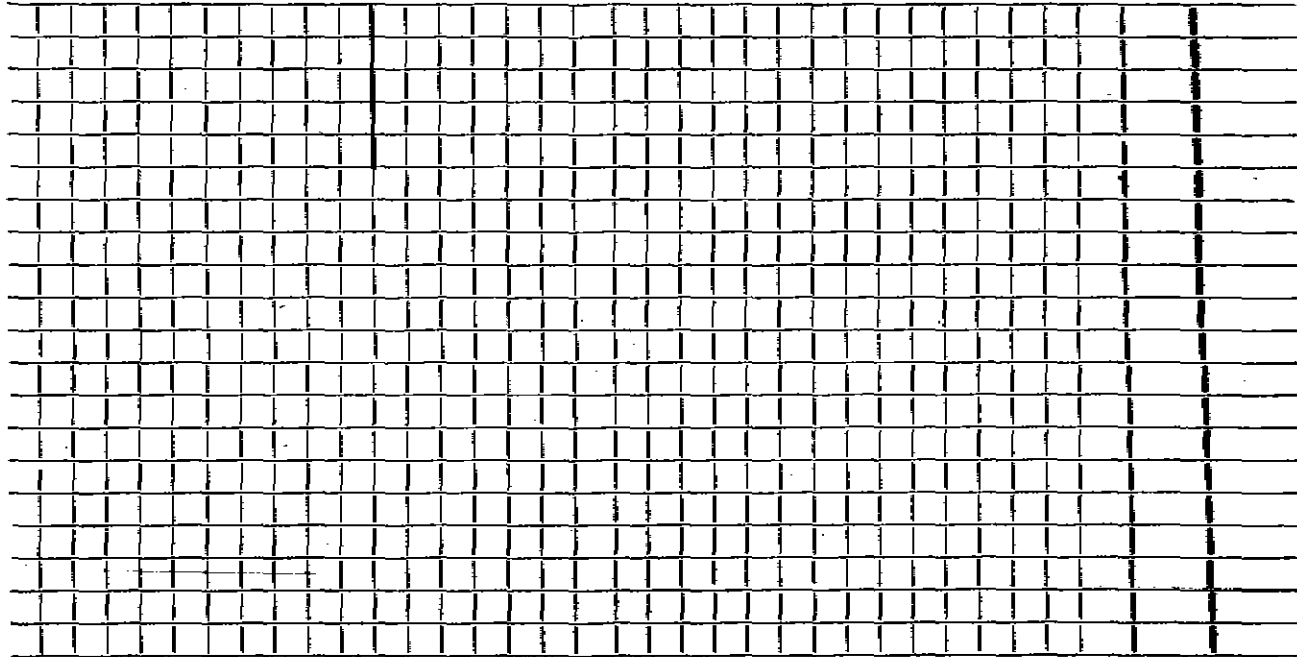

Connection made in ..... Street.      Work completed .....

Remarks: .....

.....

.....