

Name West Chester Estates

Service No. 2

Address 14 Page Road

4 Page Road

Location

Size 6"

Size of Main 8"

~~Residential~~ - New Service

Location Co. S. E. 68

Date	Material	Amount	Total	Date	Amount
9-59	LABOR	7.44		1-3-61	70.00
	10% O.H.		8.18	5-8-61	5.63
	<del>NUMBER</del> INSTALLED				64.37
	LABOR FOR SUPERVISION				
5-61	LABOR	9.68			
	10% O.H.	.97	10.65		
	48' 6" Transite pipe @.78		37.44		
	1 11/2" Transite Bend		5.10		
	1 hr. Trucking @3.00		3.00		
			64.37		


Applied to bill # 143

DATE \_\_\_\_\_

**TOWN OF LEXINGTON — BOARD OF PUBLIC WORKS**

**SEWER DIVISION**

Sketch of Service Here

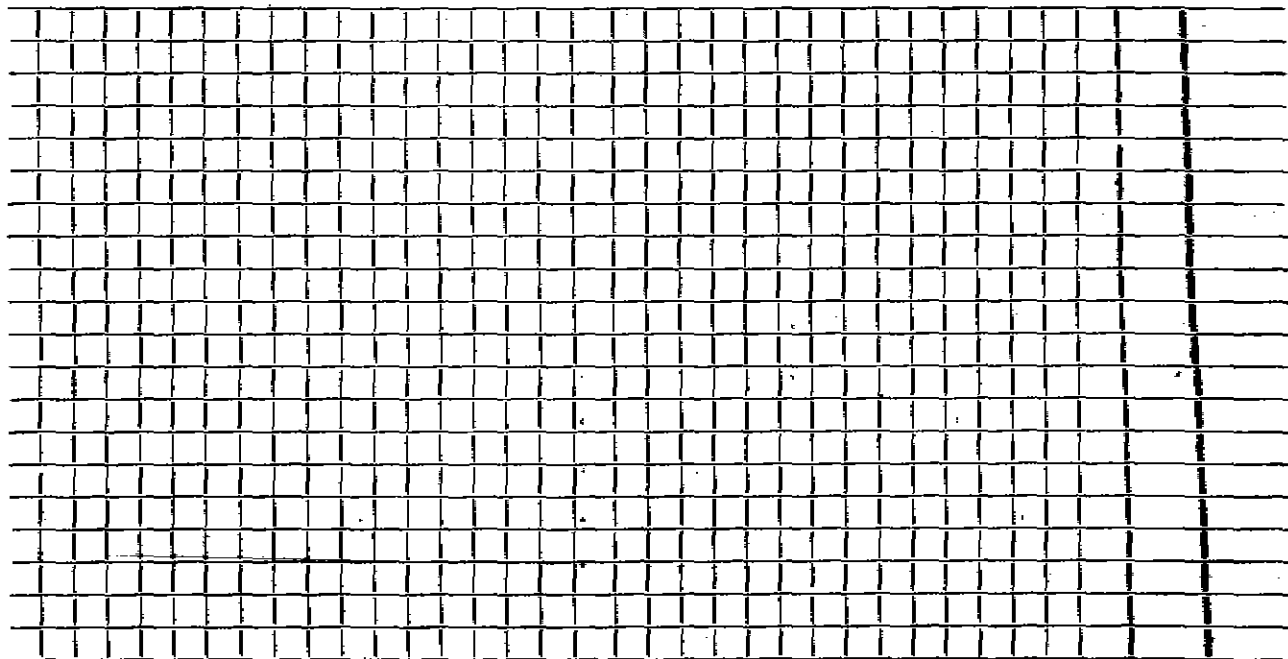

Connection made in ..... Street. Work completed .....

Remarks: .....

.....

.....