

Name West Chester Estates

Service No. 250

Address 5 Page Road

5 Page Road

Location

Kind of Pipe

Size 6"

Size of Main 8"

~~REPORT REQUIREMENTS - New Service~~

Location *Round 19-19*

Date	Material	Amount	Total	Date	Amount
1-9-59	Labor	11 16		1-28-60	6 25
	10% O. H.	1 12	12 28	1-28-60	6 25
	OWNER INSTALLED				6 25
	LABOR FOR SUPERVISION				
1-16-60	Labor	14 15			
	10% O.H.	1 42	15 57		
	55' 6" Transit pipe @.78		27 30		
	1 11-0 Transit Band		5 10		
	1 hr. Trucking @3.00		3 00		
			63 25		


Apply Card to West Chester

DATE _____

TOWN OF LEXINGTON — BOARD OF PUBLIC WORKS

SEWER DIVISION

Sketch of Service Here

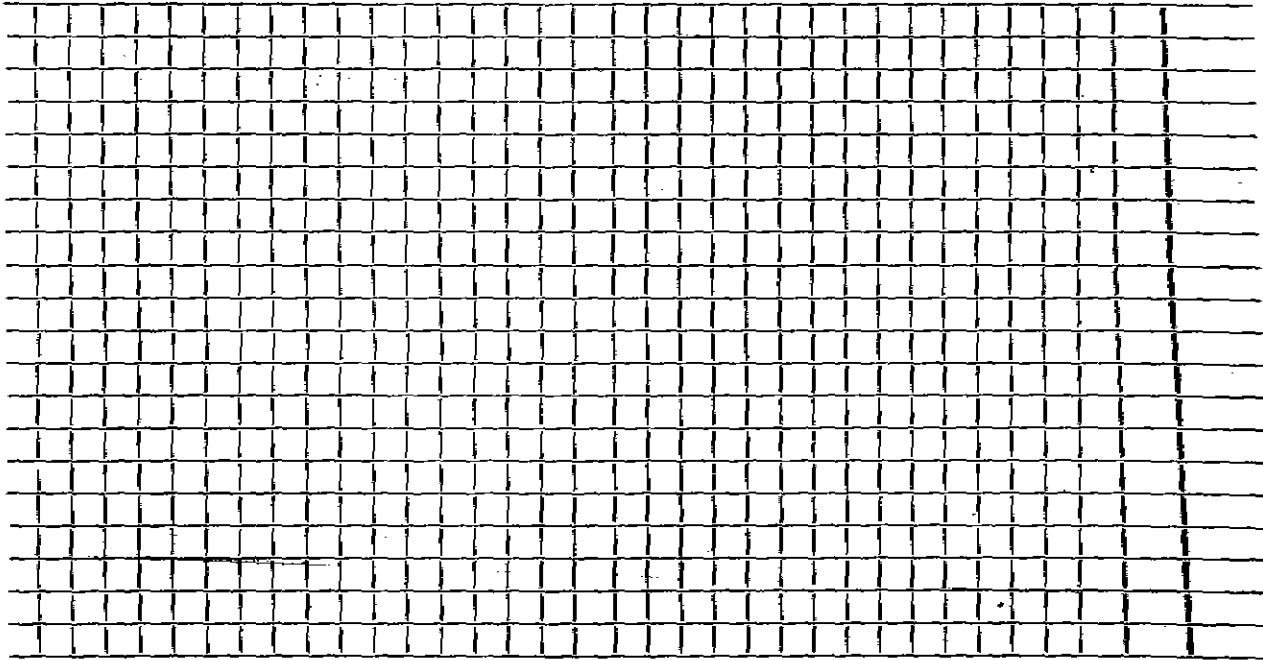

Connection made in Street. Work completed

Remarks:

.....

.....