

Name

Service No.

Address 6 Page Rd.

Location

Kind of Pipe

Size

Size of Main

Repair—Removal—New Service

Location


Date	Material	Amount	Total	Date	Amount
Feb 13 2002	25' 6" PVC				
	1- 4x6 Fernco				
	1- 22.50" 6" Bond				
	1- 6" ACx 6" PVC Fernco				

DATE Feb 13 2002

TOWN OF LEXINGTON — BOARD OF PUBLIC WORKS

SEWER DIVISION

Sketch of Service Here

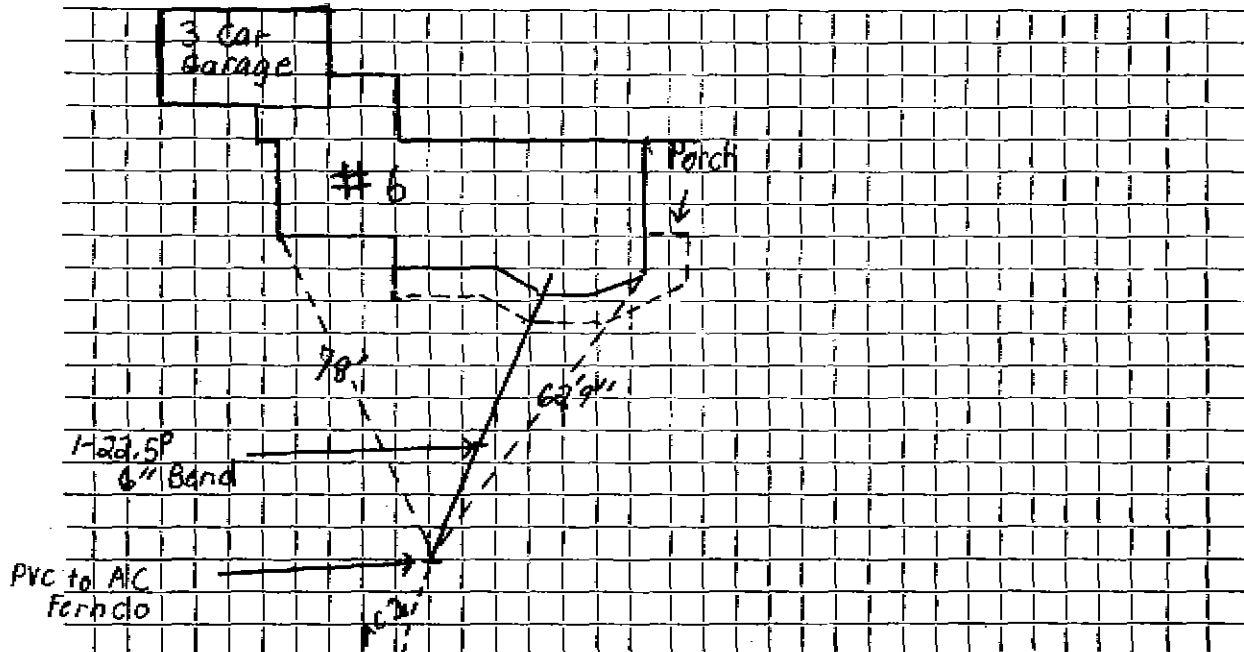

Connection made in Street. Work completed

Remarks:

.....

.....