




DATE 10-19-01

TOWN OF LEXINGTON — BOARD OF PUBLIC WORKS  
SEWER DIVISION

Sketch of Service Here

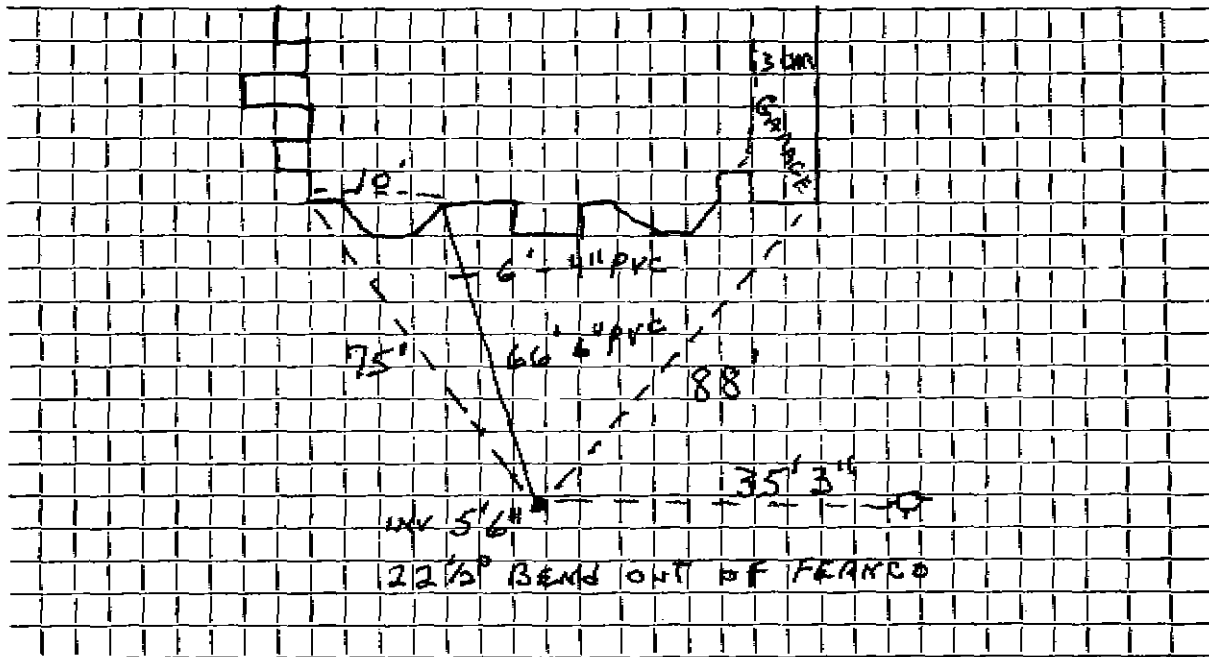

Connection made in PAGE Rd. Street. Work completed .....

Remarks: INSTALLED BY J. McLAUGHLIN .....