




TOWN OF LEXINGTON — BOARD OF PUBLIC WORKS

SEWER DIVISION

Sketch of Service Here

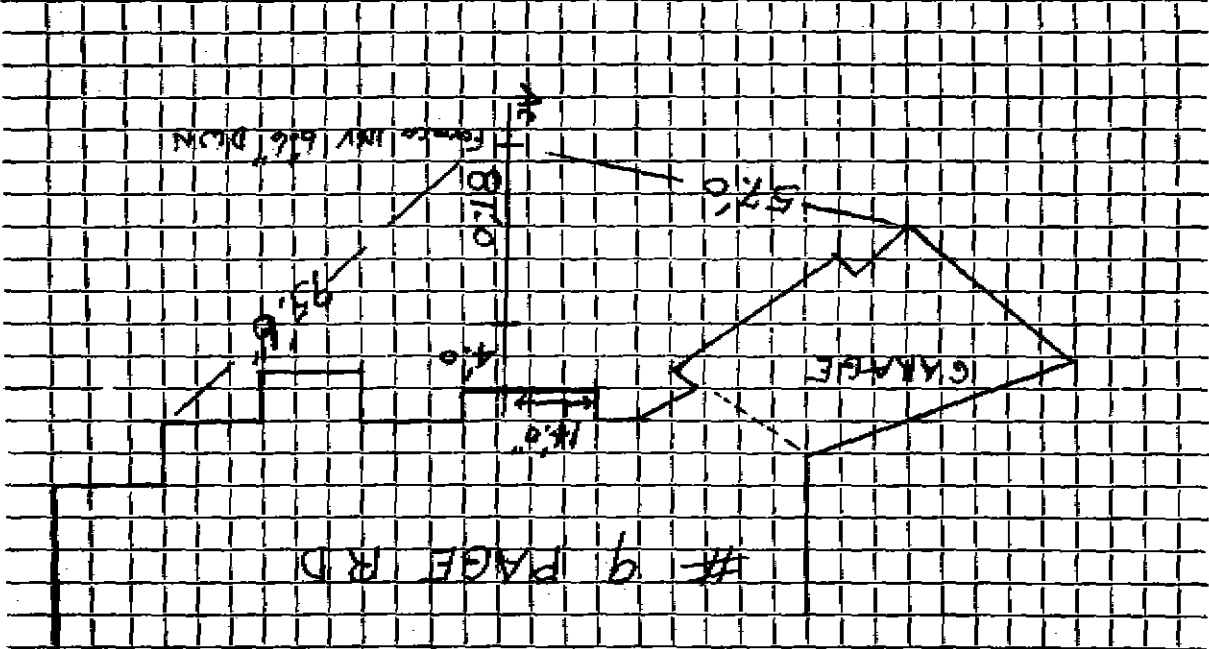

Street

Connection made in

Remarks: Tie Caves Made 1/30/07

Work completed

5/8/05

J. Milroy & Son

DATE