

Name **Moore Realty Trust**

Service No. **186**

Address **(5 Park Street)**

Mail: **59 Hancock St., Lexington, Mass.** Location

Kind of Pipe

Size **6"**

Size of Main **8"**

~~Repair~~ ~~Renewal~~ **New Service**

Location *Comm 12-31-61*


Date	Material	Amount	Total	Date	Amount
<i>1/5/61</i>	Labor	86 07		<i>12-1-61</i>	<i>Deposit</i> 250 00
	10% O.H.	8 61	94 67	<i>12-31-61</i>	<i>Retard</i> 44 93
	50' 6" Transite Pipe @ .78		39 00		185 07
	1 90° Transite Elbow		5 40		
	5 Hrs. Pippin Shovel @ 5.00		25 00		
	2 Hrs. Trucking @ 3.00		6 00		
	Spring - Leam & Seed		15 00		
<i>7-18-71</i>	Renewal		185 07		
	40' 6" Transite				
	1 6" Nipple				
	1 6" Adapter				

DATE _____

TOWN OF LEXINGTON — BOARD OF PUBLIC WORKS

SEWER DIVISION

Sketch of Service Here

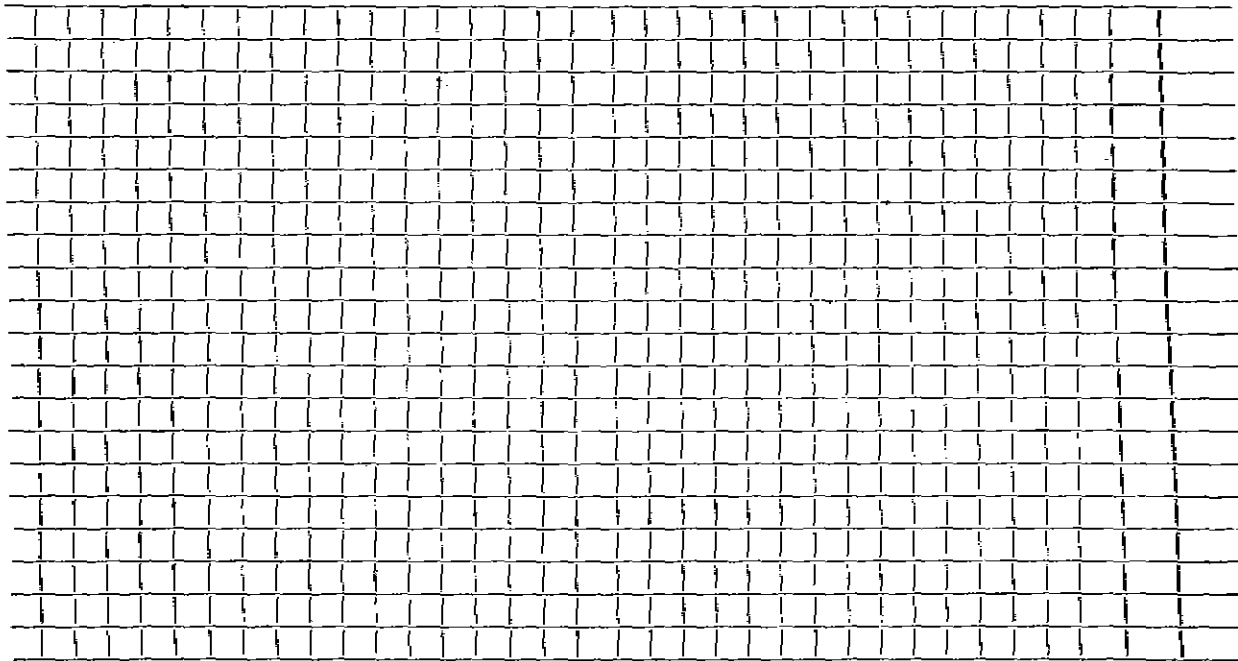

Connection made in Street. Work completed

Remarks:

.....

.....