

Name **Charles R. Mercer**

Service No. 28

Address **6 Park Street**

"Park Street"

Location

Kind of Pipe

Size **6"**

Size of Main **8"**

~~XXXXXXXXXXXXXXXXXXXX~~ New Service W.O. 2009 *Def. No. Bas Permitt #1241*

Location **JUN 27 1966**


Rate	Material	Amount	Total	Date	Amount
66	Labor	41.66		4-4-66	100 00
-66	Labor	31.16	72 82	7-25-66	50 97
	10% O.H.		7 28		130 99
	15' 6" Transite pipe @	.82	12 30	8-15-66	34 26
	1 90° Elbow		4 09	4-6-66	96 71
	1/4 Ton cold patch @ 5.00		1 25	15' 6" Transite	
	2 Ton hot top @ 5.50		11 00	1 6"x8" Wye	
	1 1/2 Hr. Tractor @ 6.50		9 75	1 6"-90° Elbow	
	2 1/2 Hr. Truck @ 3.00		7 50		
	1/2 Hr. Roller @ 3.00		1 50		
	1/2 Hr. Trailer @ 2.00		1 00		
	1/2 Hr. Compressor @ 5.00		2 50		
			130 99		
36	35' 6" Transite pipe			<i>H DPTC # 34.28 Labor 4-12-66</i>	
				<i>Should Not have been billed</i>	
				<i>to service Service Corp 4-6-66</i>	
				<i>Bill sent 36.99</i>	

DATE _____

TOWN OF LEXINGTON — BOARD OF PUBLIC WORKS

SEWER DIVISION

Sketch of Service Here **6**

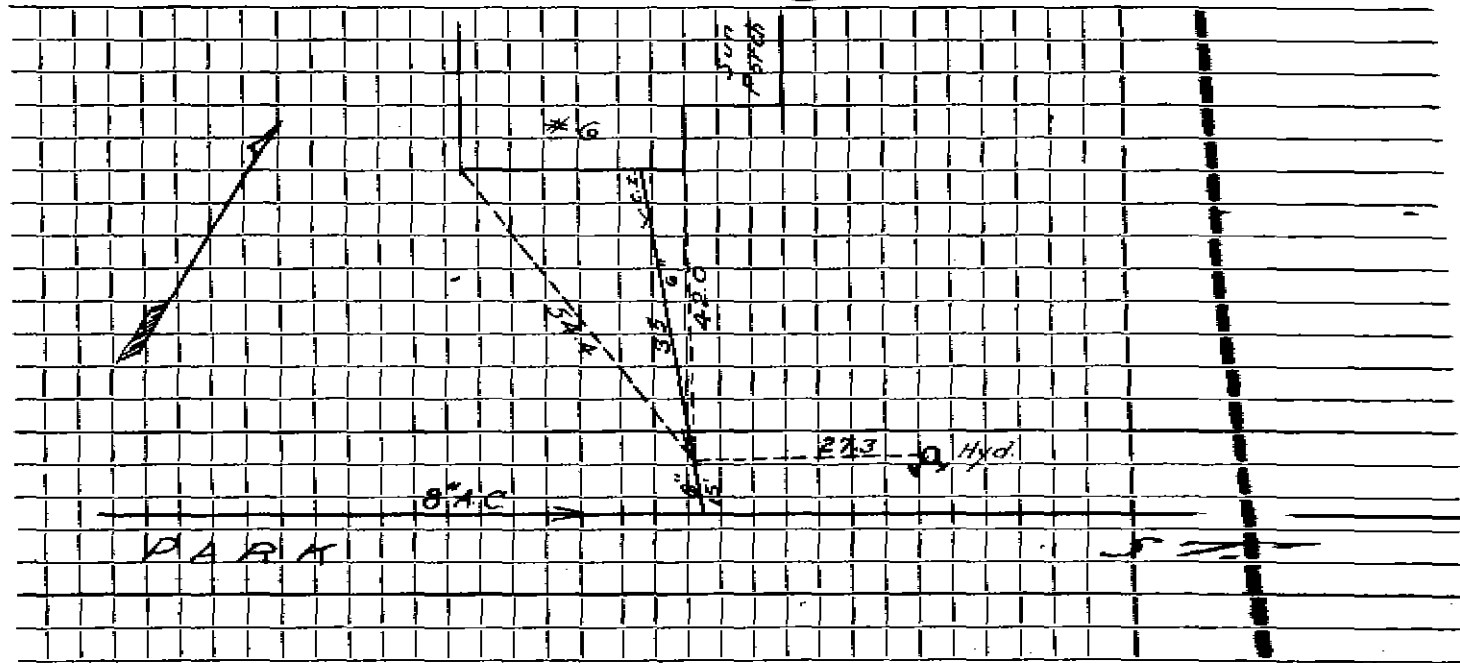

Connection made in Street. Work completed

Remarks:
.....
.....