

Name

Service No.

Address

8 Park St

Location

Kind of Pipe

Size

Size of Main


Repair—Renewal—New Service

Location

Date	Material	Amount	Total	Date	Amount
9-23-04	4x6 Formed CI to RL	1-6" 450 Band			
	1-6" 22" BEAD	1-8" - 90° Elbow			
	47' - 6" PVC				

DATE _____

TOWN OF LEXINGTON — BOARD OF PUBLIC WORKS
SEWER DIVISION

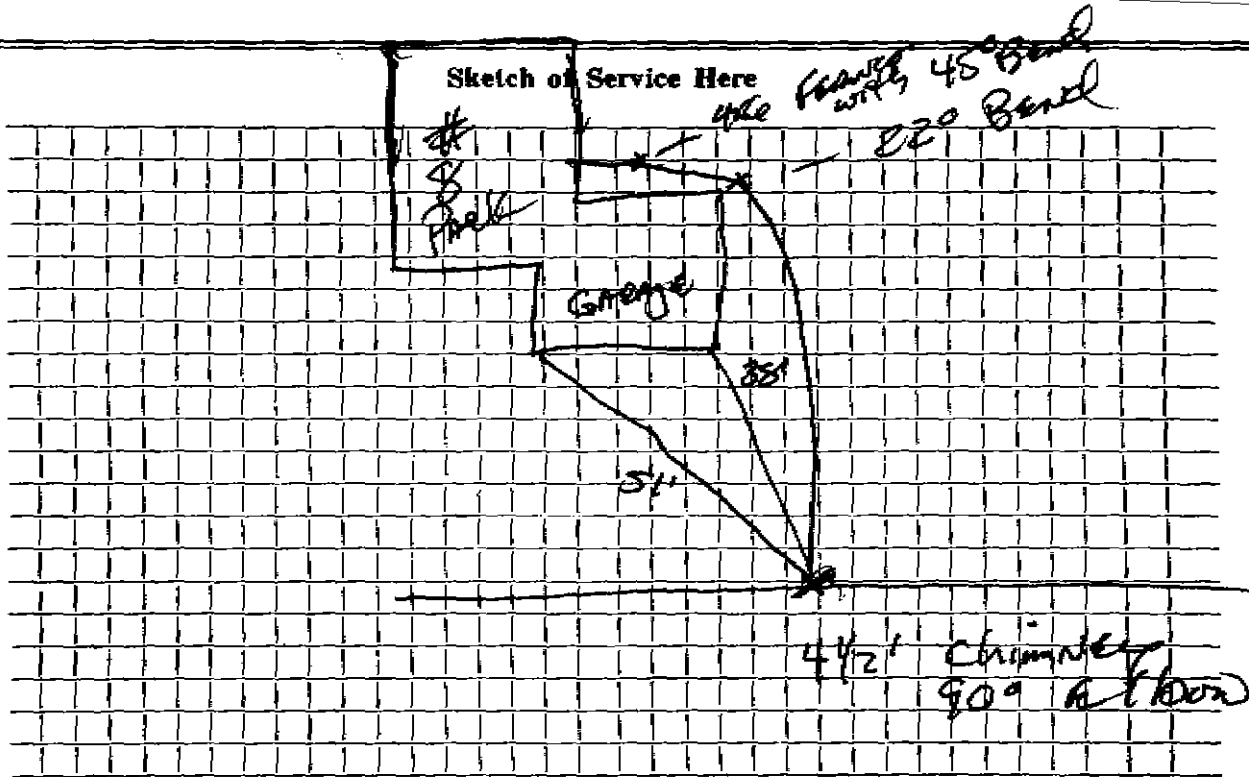

Connection made in Street. Work completed

Remarks:
.....
.....
.....