

Service No.

Address

11 Parker Street

Location

Kind of Pipe

Size 6"

Size of Main 8"

Repair—Renewal—New Service

Location


Date	Material	Amount	Total	Date	Amount
1929					
7-12-77					
24	6" TRANSITE			7-12-77	
1	6" X 9" DONUT			25	6" TRANSITE
				1	6"-1' NIPPLE
				1	6" X 8" WYE
				1	6"-90° ELBOW

DATE _____

TOWN OF LEXINGTON — BOARD OF PUBLIC WORKS

SEWER DIVISION

Sketch of Service Here //

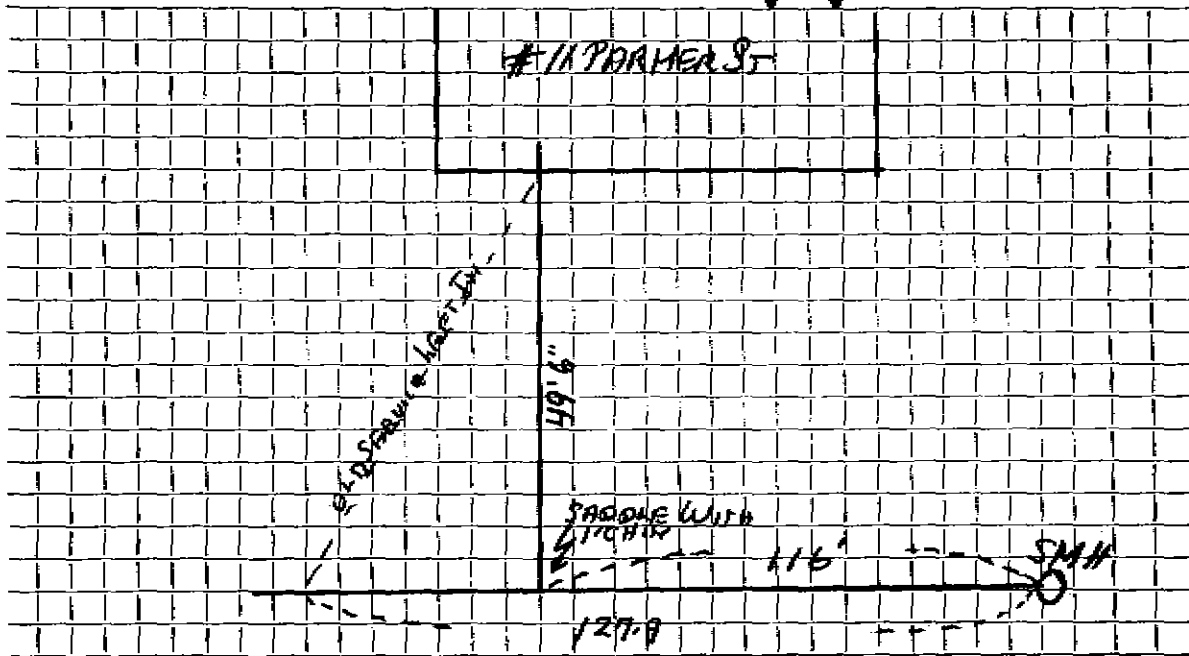

Connection made in Street. Work completed

Remarks:

.....