

Name **Willis N. Cousins**

Service No. **141**

Address **16 Parker Street**

16 Parker Street

Location

Kind of Pipe

Size **6"**

Size of Main **8"**

~~Renewal~~ ~~Work Order~~ **W.O. #8251**

Location **Comm 2-10-64**

Date	Material	Amount	Total	Date	Amount
-22-63	Labor	37.04		10-18-63	Deposit 200.00
3-63	"	33.96	71.00	2-16-64	Refund 40.84
	10% O.H.	7.10	78.10		159.16
	33' 6" Transite pipe @.82		27.06		
	4 hrs. Town Shovel @6.50		26.00		
	3 hrs. Trucking @3.00		9.00		
	10 x 3 Patch		10.00		
	3 yds. Loam @3.00		9.00		
			159.16		


DATE _____

TOWN OF LEXINGTON — BOARD OF PUBLIC WORKS

SEWER DIVISION

Sketch of Service Here

16

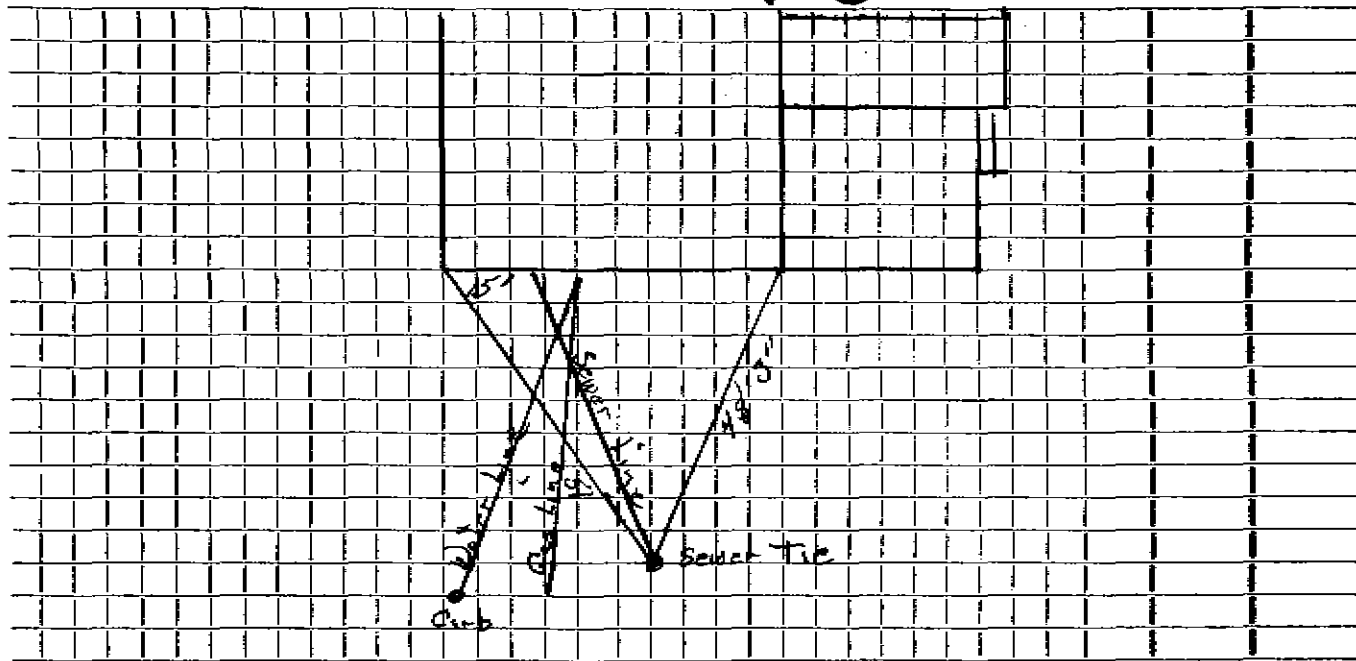

Connection made in Street.

Work completed

Remarks: *Original Service 1929*