

Serial No. 72

JACKSON CONGRY

29 PASEL ST.

Location Parker St.

Size of Main 8"

Size 6"

Kind of Pipe

Reorder-~~Reorder~~-New Service


Location

Date	Material	Amount	Total	Date	Amount
2-4-11-15	40' 4" Sewer Pipe @.22	8.80			
12-9-11	1 8" Band	70		March 20 1928	12.90
3-29-28	1 5" x 4" Reducer	1.05			
	Sulphur & Jute	1.60	12.15		
	Trucking		75		
			12.90		
	NOTE: Time on				
	Water slip				
	50' Trench Exc				
	Labor			1-5-65	Roots
				4-9-23	
			87.79		
			84		
			82		
			34		
			69		
			82		

DATE _____

TOWN OF LEXINGTON — BOARD OF PUBLIC WORKS
SEWER DIVISION

Sketch of Service Here

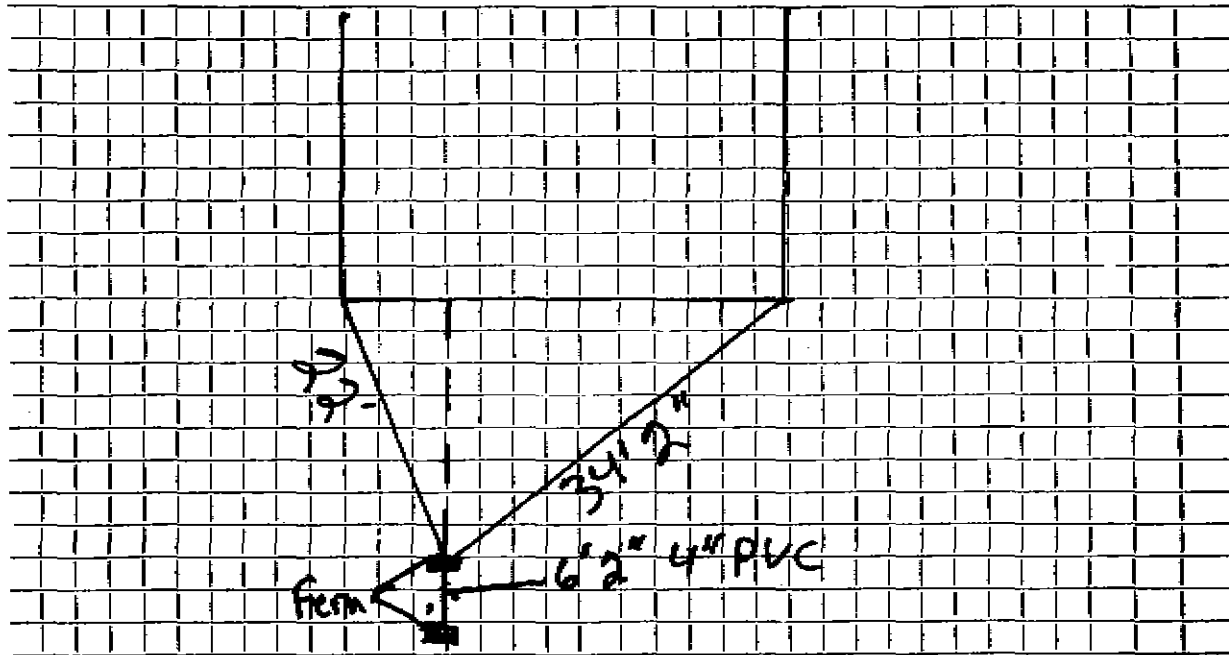

Connection made in Street. Work completed

Remarks:

.....

.....

Name

Service No.

Address

29 Parker St.

Location

Kind of Pipe

PVC

Size

4"

Size of Main

8

~~Repair~~—Renewal—New Service

Location

Date

Material

Amount

Total

Date

outside-Repair

Amount

10-31-07

6'-4" PVC

2-4"x4" Fern.

Some Roots On Property
Cleaned Out

TOWN OF LEXINGTON - BOARD OF PUBLIC WORKS

SEWER DIVISION

DATE 3/20/28

NO. _____


The undersigned applies for the construction of a particular sewer connecting No. Parker Street and hereby agrees to comply with the Rules and Regulations governing the construction and use of Particular Sewers, as now or at any future time established by the Board of Selectmen.

Am't. of Estimate \$ 75.00

Am't. Paid \$ _____

J. J. Michels Owner
6 Jackson Court

Sketch of Service Here

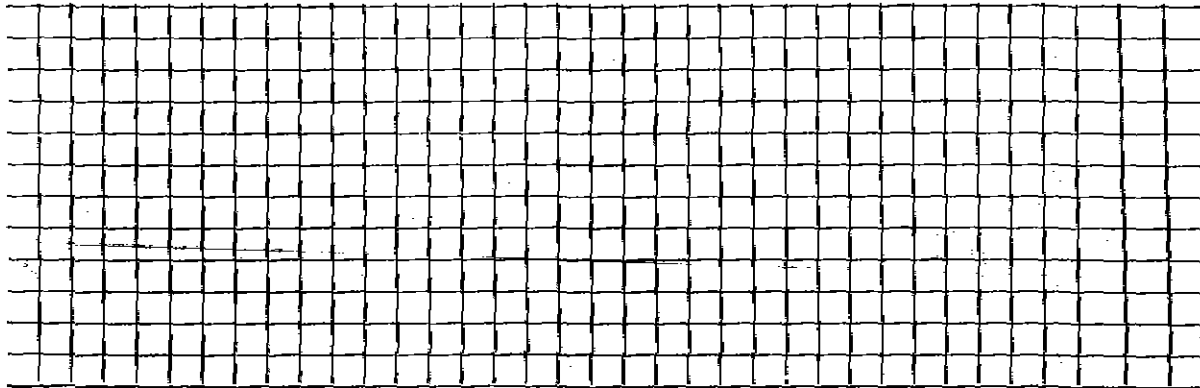

Connection made in _____ Street.

Work completed _____ 19

Remarks: