

W. H. McCallister

33 Parker Street, Lexington, Mass.

3 Parker Street

Location 33 Parker Street

Kind of Pipe

Size 6"

Size of Main 8"

Repair—Renewal—New Service

Location

Date 1941	Material	Amount	Total	Date	Amount
Nov. 22	12½ hrs. @ 50¢	6 25		Nov. 22, 1941	90.00
Nov 17/1941	32 " @ 60¢	19 20	25 45	Dec 30, 1941	32.66
	10% Overhead		2 54		57.34
	56' 6" sewer pipe @ 16¢		8 96		
	1 6" 1/8 Bend		65		
	joint compound		3 36		
	2 hrs. compressor @ 2.25		4 50		
	4 hrs. trucking @ 75¢		3 00		
	trench repairs		8 88		
			57 34		
	Labor				

TOWN OF LEXINGTON—BOARD OF PUBLIC WORKS
SEWER DIVISION

DATE _____

NO. _____


The undersigned applies for the construction of a particular sewer connecting No. 33 Parker Street Street and hereby agrees to comply with the Rules and Regulations governing the construction and use of Particular Sewers, as now or at any future time established by the Board of Selectmen.

Am't. of Estimate \$ _____

Am't. Paid \$ _____

(Miss) Helen A. McCaffrey Owner

Sketch of Service Here **33**

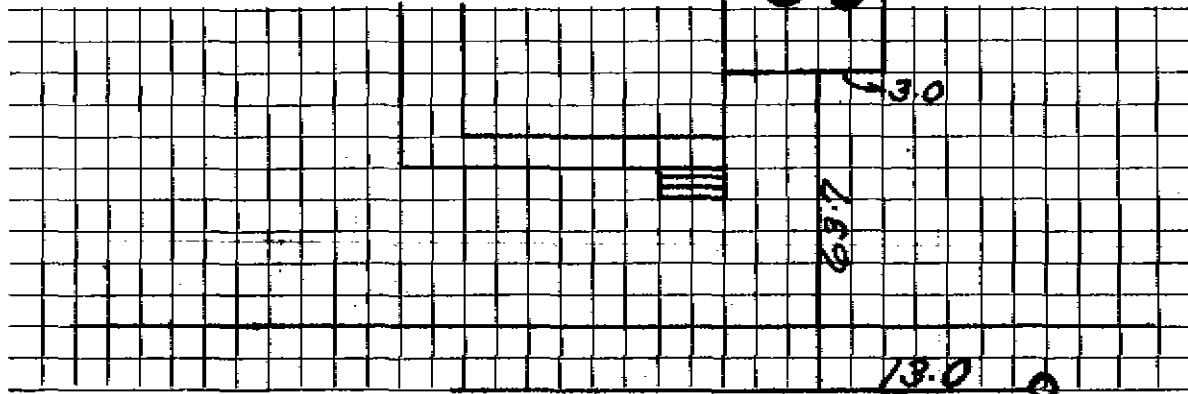

Connection made in _____ Street.

Work completed _____ 19

Remarks: