

Service No. 295

Address 34 Parker St.

34 Parker Street

Location 34 Parker Street

Kind of Pipe

Size 6"

Size of Main 8"

Repair—Renewal—New Service

Location

Date	Material	Amount	Total	Date	Amount
1929					
				7-20-29	
					Repair W.O. #605
					Labor
					1 5' x 6" Transite Nipple
					1 6" Transite Adapter to clay
					12 Red Brick
					1/2 bag Cement
					2 hrs. Pick up
					1 1/2 hr. Team Shovel
	Labor				

Hadley Bros, Inc., Lexington

TOWN OF LEXINGTON—BOARD OF PUBLIC WORKS
SEWER DIVISION

DATE _____


NO. _____

The undersigned applies for the construction of a particular sewer connecting No. 34 Parker St.
Street and hereby agrees to comply with the Rules and Regulations governing the construction and use of Particular
Sewers, as now or at any future time established by the Board of Selectmen.

Am't. of Estimate \$ _____

Am't. Paid \$ _____

_____ Owner

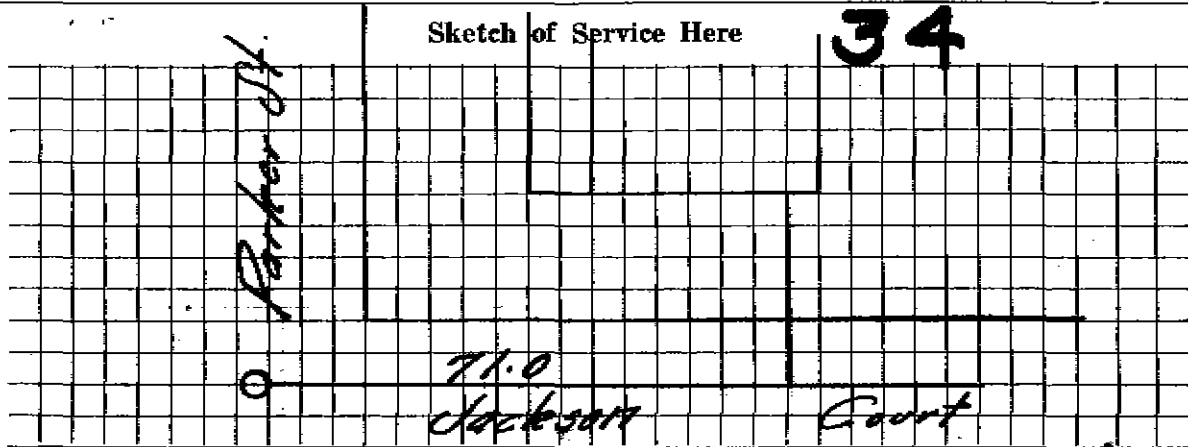

Connection made in _____ Street.

Work completed _____ 19

Remarks: